


1 LOCATION OF WATER WELL: County: Shawnee Fraction: SW 1/4 SW 1/4 SW 1/4 Section Number: 17 Township Number: T 11 S Range Number: R 16 E

Distance and direction from nearest town or city street address of well if located within city?
0111 N. Topeka Blvd.

2 WATER WELL OWNER: George Hersh Jr.
 RR#, St. Address, Box #: 108 West 8th Street
 City, State, ZIP Code: Topeka, KS.
 Board of Agriculture, Division of Water Resources
 Application Number:

3 LOCATE WELL'S LOCATION WITH AN "X" IN SECTION BOX: 4 DEPTH OF COMPLETED WELL: 21 ft. ELEVATION: NA

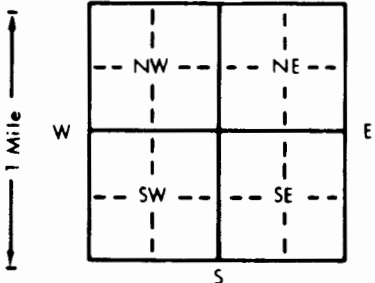

Depth(s) Groundwater Encountered 1. NA ft. 2. ft. 3. ft.
 WELL'S STATIC WATER LEVEL 17 ft. below land surface measured on mo/day/yr
 Pump test data: Well water was ft. after hours pumping gpm
 Est. Yield gpm Well water was ft. after hours pumping gpm
 Bore Hole Diameter 10 in. to ft. and in. to ft.
 WELL WATER TO BE USED AS: (5) Public water supply 8 Air conditioning 11 Injection well
 1 Domestic 3 Feedlot 6 Oil field water supply 9 Dewatering 12 Other (Specify below)
 2 Irrigation 4 Industrial 7 Lawn and garden only 10 Monitoring well
 Was a chemical/bacteriological sample submitted to Department? Yes No If yes, mo/day/yr sample was submitted

5 TYPE OF BLANK CASING USED: 5 Wrought iron 8 Concrete tile CASING JOINTS: Glued Clamped
(1) Steel 3 RMP (SR) 6 Asbestos-Cement 9 Other (specify below) Welded
 2 PVC 4 ABS 7 Fiberglass Threaded

Blank casing diameter 8 in. to ft. Dia. in. to ft. Dia. in. to ft.
 Casing height above land surface 4 below in. weight lbs./ft. Wall thickness or gauge No.

TYPE OF SCREEN OR PERFORATION MATERIAL: 7 PVC 10 Asbestos-cement
(1) Steel 3 Stainless steel 5 Fiberglass 8 RMP (SR) 11 Other (specify)
 2 Brass 4 Galvanized steel 6 Concrete tile 9 ABS 12 None used (open hole)

SCREEN OR PERFORATION OPENINGS ARE: 5 Gauzed wrapped (6) Saw cut 11 None (open hole)
 1 Continuous slot 3 Mill slot 6 Wire wrapped 9 Drilled holes
 2 Louvered shutter 4 Key punched 7 Torch cut 10 Other (specify)

SCREEN-PERFORATED INTERVALS: From NA ft. to ft. From ft. to ft.
 GRAVEL PACK INTERVALS: From NA ft. to ft. From ft. to ft.

6 GROUT MATERIAL: 1 Neat cement (2) Cement grout 3 Bentonite 4 Other
 Grout Intervals: From 8 ft. to 4 ft. From ft. to ft. From ft. to ft.

What is the nearest source of possible contamination:
 1 Septic tank 4 Lateral lines 7 Pit privy 10 Livestock pens 14 Abandoned water well
 2 Sewer lines 5 Cess pool 8 Sewage lagoon 11 Fuel storage 15 Oil well/Gas well
 3 Watertight sewer lines 6 Seepage pit 9 Feedyard 12 Fertilizer storage 16 Other (specify below)
 Direction from well? All around How many feet? 0

FROM	TO	LITHOLOGIC LOG	FROM	TO	PLUGGING INTERVALS
<u>21</u>	<u>17</u>	<u>Sand</u> <u>Clay</u> <u>Cement Grout</u> <u>Clay</u>			
<u>17</u>	<u>8</u>				
<u>8</u>	<u>4</u>				
<u>4</u>	<u>0</u>				

7 CONTRACTOR'S OR LANDOWNER'S CERTIFICATION: This water well was (1) constructed, (2) reconstructed, or (3) plugged under my jurisdiction and was completed on (mo/day/year) 7-7-90 and this record is true to the best of my knowledge and belief, Kansas Water Well Contractor's License No. This Water Well Record was completed on (mo/day/yr) 7-10-90 under the business name of Allen Bush by (signature) [Signature]

OFFICE USE ONLY
T
R
EW
SEC
1/4
1/4
1/4