


1 LOCATION OF WATER WELL: Fraction NE 1/4 SW 1/4 NW 1/4 Section Number 18 Township Number T 11 S Range Number R 16 E

Distance and direction from nearest town or city street address of well if located within city? Approximately 900' North of NW 25th St. at Youth Center of Topeka facility

2 WATER WELL OWNER: Youth Center at Topeka STATE OF KANSAS 1440 NW 24th St. Topeka, KS Board of Agriculture, Division of Water Resources RR#, St. Address, Box #: Controlled by Dept. of Corrections Application Number: N/A City, State, ZIP Code:

3 LOCATE WELL'S LOCATION WITH AN "X" IN SECTION BOX:

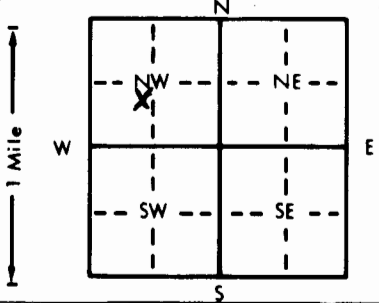

4 DEPTH OF COMPLETED WELL: 45.5 ft. ELEVATION: Not surveyed. Depth(s) Groundwater Encountered 1. 37' ft. 2. ft. 3. ft. WELL'S STATIC WATER LEVEL: 35 ft. below land surface measured on mo/day/yr 8/27/91. Pump test data: Well water was ft. after hours pumping gpm. Est. Yield gpm: Well water was ft. after hours pumping gpm. Bore Hole Diameter: 7.5/8 in. to ft., and in. to ft. WELL WATER TO BE USED AS: 5 Public water supply 8 Air conditioning 11 Injection well 1 Domestic 3 Feedlot 6 Oil field water supply 9 Dewatering 12 Other (Specify below) 2 Irrigation 4 Industrial 7 Lawn and garden only 10 Observation well. Was a chemical/bacteriological sample submitted to Department? Yes No; If yes, mo/day/yr sample was submitted Water Well Disinfected? Yes No

5 TYPE OF BLANK CASING USED: 1 Steel 2 PVC 3 RMP (SR) 4 ABS 5 Wrought iron 6 Asbestos-Cement 7 Fiberglass 8 Concrete tile 9 Other (specify below) CASING JOINTS: Glued Clamped Welded Threaded

Blank casing diameter 2 in. to ft., Dia. in. to ft., Dia. in. to ft. Casing height above land surface 36'' in., weight lbs./ft. Wall thickness or gauge No. SCH 40

TYPE OF SCREEN OR PERFORATION MATERIAL: 1 Steel 2 Brass 3 Stainless steel 4 Galvanized steel 5 Fiberglass 6 Concrete tile 7 PVC 8 RMP (SR) 9 ABS 10 Asbestos-cement 11 Other (specify) 12 None used (open hole)

SCREEN OR PERFORATION OPENINGS ARE: 1 Continuous slot 2 Louvered shutter 3 Mill slot 4 Key punched 5 Gauzed wrapped 6 Wire wrapped 7 Torch cut 8 Saw cut 9 Drilled holes 10 Other (specify) 11 None (open hole)

SCREEN-PERFORATED INTERVALS: From 25.5 ft. to 45.5 ft. GRAVEL PACK INTERVALS: From 23.5 ft. to 45.5 ft.

6 GROUT MATERIAL: 1 Neat cement 2 Cement grout 3 Bentonite 4 Other Grout Intervals: From 21.0 ft. to 23.5 ft. From 0 ft. to 21.0 ft.

What is the nearest source of possible contamination: 1 Septic tank 2 Sewer lines 3 Watertight sewer lines 4 Lateral lines 5 Cess pool 6 Seepage pit 7 Pit privy 8 Sewage lagoon 9 Feedyard 10 Livestock pens 11 Fuel storage 12 Fertilizer storage 13 Insecticide storage 14 Abandoned water well 15 Oil well/Gas well 16 Other (specify below) Leaking UST removed

Direction from well? How many feet? Formerly 3', Currently 50'

FROM	TO	LITHOLOGIC LOG	FROM	TO	LITHOLOGIC LOG
0	3'	Fill soil, lean, black			
3'	6'	Silty clay, dk br to black			
6'	8'	Silty clay, dk br to grey			
8'	12'	Clayey silt, lt. to dk grey			
12'	18'	Clayey silt, silty clay, grey			
18'	25'	Clay, grey, becoming stiff			
25'	30'	Med-Hvy clay to fine sand			
30'	35'	Fine to med sand, wet			
35'	40'	Med-coarse sand			
40'	45.5'	Fine to coarse sand			
		Note: Strong petroleum odors began at 8' increasing in concentration w/ depth			

7 CONTRACTOR'S OR LANDOWNER'S CERTIFICATION: This water well was (1) constructed (2) reconstructed, or (3) plugged under my jurisdiction and was completed on (mo/day/year) Aug. 27, 1991 and this record is true to the best of my knowledge and belief. Kansas Water Well Contractor's License No. This Water Well Record was completed on (mo/day/yr) Sept. 11, 1991 under the business name of KDHE - BER by signature Daniel J. Kellerman