


Distance and direction from nearest town or city street address of well if located within city?
1440 NW 25th, TOPEKA, KS

2 WATER WELL OWNER: YOUTH CENTER AT TOPEKA
 RR#, St. Address, Box #: 1440 NW 25th
 City, State, ZIP Code: TOPEKA, KS 66618
 Board of Agriculture, Division of Water Resources
 Application Number:

3 LOCATE WELL'S LOCATION WITH AN "X" IN SECTION BOX:

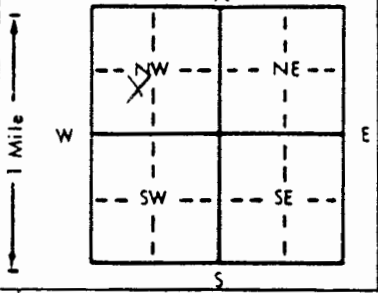

4 DEPTH OF COMPLETED WELL: 28 ft. ELEVATION: 892.93
 Depth(s) Groundwater Encountered 1. 2.3 ft. 2. ft. 3. ft.
 WELL'S STATIC WATER LEVEL: 22.34 ft. below land surface measured on mo/day/yr 5-8-93
 Pump test data: Well water was ft. after hours pumping gpm
 Est. Yield gpm: Well water was ft. after hours pumping gpm
 Bore Hole Diameter: 7.5/8 in. to 28 ft., and in. to ft.
 WELL WATER TO BE USED AS:
 5 Public water supply 8 Air conditioning 11 Injection well
 1 Domestic 3 Feedlot 6 Oil field water supply 9 Dewatering 12 Other (Specify below)
 2 Irrigation 4 Industrial 7 Lawn and garden only 10 Monitoring well
 Was a chemical/bacteriological sample submitted to Department? Yes No X; If yes, mo/day/yr sample was submitted
 Water Well Disinfected? Yes No X

5 TYPE OF BLANK CASING USED:
 1 Steel 3 RMP (SR) 5 Wrought iron 8 Concrete tile CASING JOINTS: Glued Clamped
2 PVC 4 ABS 6 Asbestos-Cement 9 Other (specify below) Welded
 7 Fiberglass Threaded X
 Blank casing diameter 0 in. to 18 ft., Dia. in. to ft., Dia. in. to ft.
 Casing height above land surface 35 in., weight lbs./ft. Wall thickness or gauge No. 5.5/4.90
 TYPE OF SCREEN OR PERFORATION MATERIAL: 2 PVC 10 Asbestos-cement
 1 Steel 3 Stainless steel 5 Fiberglass 8 RMP (SR) 11 Other (specify)
 2 Brass 4 Galvanized steel 6 Concrete tile 9 ABS 12 None used (open hole)
 SCREEN OR PERFORATION OPENINGS ARE:
 1 Continuous slot 3 Mill slot 5 Gauzed wrapped 8 Saw cut 11 None (open hole)
 2 Louvered shutter 4 Key punched 6 Wire wrapped 9 Drilled holes
 7 Torch cut 10 Other (specify)
 SCREEN-PERFORATED INTERVALS: From 18 ft. to 28 ft., From ft. to ft.
 From ft. to ft., From ft. to ft.
 GRAVEL PACK INTERVALS: From 16 ft. to 28 ft., From ft. to ft.
 From ft. to ft., From ft. to ft.

6 GROUT MATERIAL: 1 Neat cement 2 Cement grout 3 Bentonite 4 Other
 Grout Intervals: From 0 ft. to 14 ft., From 14 ft. to 16 ft., From ft. to ft.
 What is the nearest source of possible contamination:
 1 Septic tank 4 Lateral lines 7 Pit privy 11 Fuel storage 14 Abandoned water well
 2 Sewer lines 5 Cess pool 8 Sewage lagoon 12 Fertilizer storage 15 Oil well/Gas well
 3 Watertight sewer lines 6 Seepage pit 9 Feedyard 13 Insecticide storage 16 Other (specify below)

Direction from well? SOUTH WEST How many feet? 225'

FROM	TO	LITHOLOGIC LOG	FROM	TO	PLUGGING INTERVALS
0	3.5	TOP SOIL, BRN/BLK			
3.5	15	CLAY, BRN, F. SANDY, SILTY			MW3
15	19.5	SAND, BRN, F, CLAYE!!			
19.5	20.6	CLAY, GY/BRN, SANDY			
20.6	23	SAND, BRN RD, M-C			
23	28	SAND, BRN, M-C			

7 CONTRACTOR'S OR LANDOWNER'S CERTIFICATION: This water well was (1) constructed, (2) reconstructed, or (3) plugged under my jurisdiction and was completed on (mo/day/year) 5-23-93 and this record is true to the best of my knowledge and belief. Kansas Water Well Contractor's License No. 5221 This Water Well Record was completed on (mo/day/yr) 7-8-93 under the business name of GEOCORE SERVICES INC by (signature) Dale Todd