


1) LOCATION OF WATER WELL: Fraction NE 1/4 SW 1/4 NW 1/4 Section Number 18 Township Number T 11 S Range Number R 16 E/W
 County: SHAWNEE

Distance and direction from nearest town or city street address of well if located within city?
1440 NW 25th TOPEKA KS

2) WATER WELL OWNER: YOUTH CENTER AT TOPEKA
 RR#, St. Address, Box #: 1440 NW 25th Board of Agriculture, Division of Water Resources
 City, State, ZIP Code: TOPEKA, KS 66618 Application Number:

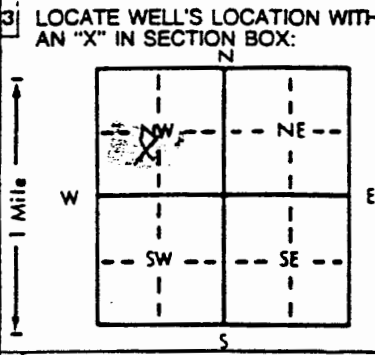

4) DEPTH OF COMPLETED WELL: 42 ft. ELEVATION: 891.53
 Depth(s) Groundwater Encountered 36 ft. 2. 36 ft. 3. 36 ft.
 WELL'S STATIC WATER LEVEL 31.30 ft. below land surface measured on mo/day/yr 5-8-93
 Pump test data: Well water was _____ ft. after _____ hours pumping _____ gpm
 Est. Yield _____ gpm Well water was _____ ft. after _____ hours pumping _____ gpm
 Bore Hole Diameter: 7.58 in. to 4.2 in. and _____ in. to _____ in.
 WELL WATER TO BE USED AS:
 5 Public water supply 8 Air conditioning 11 Injection well
 1 Domestic 3 Feedlot 6 Oil field water supply 9 Dewatering 12 Other (Specify below)
 2 Irrigation 4 Industrial 7 Lawn and garden only 10 Monitoring well
 Was a chemical/bacteriological sample submitted to Department? Yes _____ No X If yes, mo/day/yr sample was submitted _____
 Water Well Disinfected? Yes _____ No X

5) TYPE OF BLANK CASING USED:
 1 Steel 3 RMP (SR) 5 Wrought iron 8 Concrete tile CASING JOINTS: Glued _____ Clamped _____
2 PVC 4 ABS 6 Asbestos-Cement 9 Other (specify below) Welded _____
 7 Fiberglass Threaded X
 Blank casing diameter 2 in. to 2.7 in. Dia. _____ in. to _____ in. Dia. _____ in. to _____ in. Dia. _____ in. to _____ in. Dia.
 Casing height above land surface 10 in. weight _____ lbs./ft. Wall thickness or gauge No. SCH 40
 TYPE OF SCREEN OR PERFORATION MATERIAL:
 1 Steel 3 Stainless steel 5 Fiberglass 8 RMP (SR) 10 Asbestos-cement
 2 Brass 4 Galvanized steel 6 Concrete tile 9 ABS 11 Other (specify) _____
 12 None used (open hole)
 SCREEN OR PERFORATION OPENINGS ARE:
 1 Continuous slot 3 Mill slot 5 Gauzed wrapped 8 Saw cut 11 None (open hole)
 2 Louvered shutter 4 Key punched 6 Wire wrapped 9 Drilled holes
 7 Torch cut 10 Other (specify) _____
 SCREEN-PERFORATED INTERVALS: From 2.7 ft. to 4.2 ft. From _____ ft. to _____ ft.
 From _____ ft. to _____ ft. From _____ ft. to _____ ft.
 GRAVEL PACK INTERVALS: From 2.5 ft. to 4.2 ft. From _____ ft. to _____ ft.
 From _____ ft. to _____ ft. From _____ ft. to _____ ft.

6) GROUT MATERIAL: 1 Neat cement 2 Cement grout 3 Bentonite 4 Other _____
 Grout Intervals: From 2.1 ft. to 2.1 ft. From 2.1 ft. to 2.5 ft. From _____ ft. to _____ ft.
 What is the nearest source of possible contamination:
 1 Septic tank 4 Lateral lines 7 Pit privy 10 Livestock pens 14 Abandoned water well
 2 Sewer lines 5 Cess pool 8 Sewage lagoon 11 Fuel storage 15 Oil well/Gas well
 3 Watertight sewer lines 6 Seepage pit 9 Feedyard 12 Fertilizer storage 16 Other (specify below)
 13 Insecticide storage
 Direction from well? SOUTH How many feet? 25'

FROM	TO	LITHOLOGIC LOG	FROM	TO	PLUGGING INTERVALS
0	4	BACKFILL, BLACK			
4	9	CLAY, BRN/BLK, F. SANDY, SILTY			MU 2
9	10	CLAY, BK/GY, SILTY			
10	24.5	CLAY, BK/GY, F. SANDY, SILTY			
24.5	29.5	CLAY, GY, F. SANDY			
29	35.5	CLAY, GY/BLK, F. SANDY			
35.5	42	SAND, GY/BLK, M-C, CLAYEY			

7) CONTRACTOR'S OR LANDOWNER'S CERTIFICATION: This water well was 1 constructed, (2) reconstructed, or (3) plugged under my jurisdiction and was completed on (mo./day/year) 5-23-93 and this record is true to the best of my knowledge and belief. Kansas Water Well Contractor's License No. 527 This Water Well Record was completed on (mo./day/yr) 7-8-93 under the business name of GEOCORE SERVICES, INC by (signature) Dale Roll