


LOCATION OF WATER WELL: County: **SHAWNEE** Fraction: **SE 1/4 SE 1/4 SE 1/4** Section Number: **10** Township Number: **T 11 S** Range Number: **R 16 E**

Distance and direction from nearest town or city street address of well if located within city?
834 NORTH MADISON TOPEKA, KS

WATER WELL OWNER: **ELLIS NEECHAM**
 RR#, St. Address, Box #: **834 NORTH MADISON** Board of Agriculture, Division of Water Resources
 City, State, ZIP Code: **TOPEKA, KS 66605** Application Number:

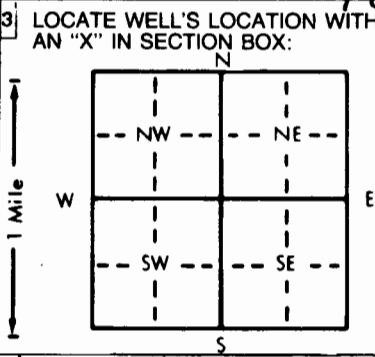

4 DEPTH OF COMPLETED WELL: **32** ft. ELEVATION:
 Depth(s) Groundwater Encountered 1. **25** ft. 2. ft. 3. **9-19-91**
 WELL'S STATIC WATER LEVEL: **25** ft. below land surface measured on mo/day/yr
 Pump test data: Well water was ft. after hours pumping gpm
 Est. Yield gpm: Well water was ft. after hours pumping gpm
 Bore Hole Diameter: **9"** in. to ft., and in. to ft.
 WELL WATER TO BE USED AS:
 5 Public water supply 8 Air conditioning 11 Injection well
 1 Domestic 3 Feedlot 6 Oil field water supply 9 Dewatering 12 Other (Specify below)
 2 Irrigation 4 Industrial 7 Lawn and garden only **10** Monitoring well
 Was a chemical/bacteriological sample submitted to Department? Yes No **X**; If yes, mo/day/yr sample was submitted
 Water Well Disinfected? Yes No **X**

5 TYPE OF BLANK CASING USED:
 1 Steel 3 RMP (SR) 5 Wrought iron 8 Concrete tile CASING JOINTS: Glued **X** Clamped
2 PVC 4 ABS 6 Asbestos-Cement 9 Other (specify below) Welded
 7 Fiberglass Threaded
 Blank casing diameter: **5** in. to **27** ft. Dia. in. to ft. Dia. in. to ft.
 Casing height above land surface: **36"** in., weight lbs./ft. Wall thickness or gauge No. **SDR-26**
 TYPE OF SCREEN OR PERFORATION MATERIAL:
7 PVC 10 Asbestos-cement
 1 Steel 3 Stainless steel 5 Fiberglass 8 RMP (SR) 11 Other (specify)
 2 Brass 4 Galvanized steel 6 Concrete tile 9 ABS 12 None used (open hole)
 SCREEN OR PERFORATION OPENINGS ARE:
 1 Continuous slot **3** Mill slot 5 Gauzed wrapped 8 Saw cut 11 None (open hole)
 2 Louvered shutter 4 Key punched 6 Wire wrapped 9 Drilled holes
 7 Torch cut 10 Other (specify)
 SCREEN-PERFORATED INTERVALS: From **27** ft. to **32** ft. From ft. to ft.
 From ft. to ft. From ft. to ft.
 GRAVEL PACK INTERVALS: From **21** ft. to **32** ft. From ft. to ft.
 From ft. to ft. From ft. to ft.

6 GROUT MATERIAL: **1** neat cement 2 Cement grout 3 Bentonite 4 Other
 Grout intervals: From **0** ft. to **21** ft., From ft. to ft. From ft. to ft.
 What is the nearest source of possible contamination:
 1 Septic tank 4 Lateral lines 7 Pit privy 10 Livestock pens 14 Abandoned water well
 2 Sewer lines 5 Cess pool 8 Sewage lagoon 11 Fuel storage 15 Oil well/Gas well
3 Watertight sewer lines 6 Seepage pit 9 Feedyard 12 Fertilizer storage 16 Other (specify below)
 13 Insecticide storage
 Direction from well? **WEST** How many feet? **60**

FROM	TO	LITHOLOGIC LOG	FROM	TO	PLUGGING INTERVALS
0	2	SOIL FILL			
2	12	YELLOW CLAY			
12	16	BLACK CLAY			
16	21	SANDY YELLOW CLAY			
21	28	FINE SAND			
28	32	COARSE SAND			

7 CONTRACTOR'S OR LANDOWNER'S CERTIFICATION: This water well was **1** constructed, (2) reconstructed, or (3) plugged under my jurisdiction and was completed on (mo/day/year) **9-20-91** and this record is true to the best of my knowledge and belief. Kansas Water Well Contractor's License No. **536** This Water Well Record was completed on (mo/day/yr) **10-2-91** under the business name of **Patchen Pump & Well Drilling Inc.** by (signature) **Jerry E. Patchen Jr.**

OFFICE USE ONLY