


1 LOCATION OF WATER WELL: County: **Shawnee** Fraction: **SE 1/4 SE 1/4 SW 1/4** Section Number: **20** Township Number: **T 11 S** Range Number: **R 16 E/W**

Distance and direction from nearest town or city street address of well if located within city?
1726 N Topeka, Topeka, Ks.

2 WATER WELL OWNER: **Alan W. Rolley**
 RR#, St. Address, Box #: **2100 S.E. 29th**
 City, State, ZIP Code: **Topeka, Ks. 66605**
 Board of Agriculture, Division of Water Resources
 Application Number: _____

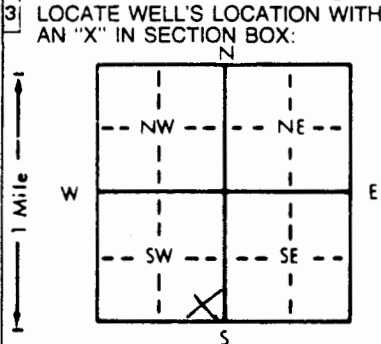

4 DEPTH OF COMPLETED WELL: **34** ft. ELEVATION: **886.76**
 Depth(s) Groundwater Encountered 1. **27** ft. 2. _____ ft. 3. _____ ft.
 WELL'S STATIC WATER LEVEL **25.14** ft. below land surface measured on mo/day/yr **6-9-93**
 Pump test data: Well water was _____ ft. after _____ hours pumping _____ gpm
 Est. Yield _____ gpm: Well water was _____ ft. after _____ hours pumping _____ gpm
 Bore Hole Diameter **7.5** | **8** in. to **34** ft., and _____ in. to _____ ft.
 WELL WATER TO BE USED AS:
 5 Public water supply 8 Air conditioning 11 Injection well
 1 Domestic 3 Feedlot 6 Oil field water supply 9 Dewatering 12 Other (Specify below)
 2 Irrigation 4 Industrial 7 Lawn and garden only **10** Monitoring well
 Was a chemical/bacteriological sample submitted to Department? Yes _____ No **X** _____; If yes, mo/day/yr sample was submitted _____
 Water Well Disinfected? Yes _____ No **X** _____

5 TYPE OF BLANK CASING USED:
 1 Steel 3 RMP (SR) 5 Wrought iron 8 Concrete tile CASING JOINTS: Glued _____ Clamped _____
2 PVC 4 ABS 6 Asbestos-Cement 9 Other (specify below) Welded _____
 7 Fiberglass _____ Threaded _____ **X** _____
 Blank casing diameter **2** in. to **19** ft., Dia _____ in. to _____ ft., Dia _____ in. to _____ ft.
 Casing height above land surface **32** in., weight _____ lbs./ft. Wall thickness or gauge No. **Sch. 40**
 TYPE OF SCREEN OR PERFORATION MATERIAL:
 1 Steel 3 Stainless steel 5 Fiberglass **7** PVC 10 Asbestos-cement
 2 Brass 4 Galvanized steel 6 Concrete tile 8 RMP (SR) 11 Other (specify) _____
 12 None used (open hole)
 SCREEN OR PERFORATION OPENINGS ARE:
 1 Continuous slot **3** Mill slot 5 Gauzed wrapped 8 Saw cut 11 None (open hole)
 2 Louvered shutter 4 Key punched 6 Wire wrapped 9 Drilled holes
 7 Torch cut 10 Other (specify) _____
 SCREEN-PERFORATED INTERVALS: From _____ ft. to **19** ft. to **34** ft. From _____ ft. to _____ ft.
 From _____ ft. to _____ ft. From _____ ft. to _____ ft.
 GRAVEL PACK INTERVALS: From _____ ft. to **17** ft. to **34** ft. From _____ ft. to _____ ft.
 From _____ ft. to _____ ft. From _____ ft. to _____ ft.

6 GROUT MATERIAL: 1 Neat cement **2** Cement grout **3** Bentonite 4 Other _____
 Grout Intervals: From _____ ft. to **15** ft., From **15** ft. to **17** ft., From _____ ft. to _____ ft.
 What is the nearest source of possible contamination:
 1 Septic tank 4 Lateral lines 7 Pit privy **10** Livestock pens 14 Abandoned water well
 2 Sewer lines 5 Cess pool 8 Sewage lagoon **11** Fuel storage 15 Oil well/Gas well
 3 Watertight sewer lines 6 Seepage pit 9 Feedyard 12 Fertilizer storage 16 Other (specify below)
 13 Insecticide storage _____
 Direction from well? **West** How many feet? **5**

FROM	TO	LITHOLOGIC LOG	FROM	TO	PLUGGING INTERVALS
0	4.5	Backfill, brn blk			
4.5	5.6	Sand, brn, F-M			MW 1
5.6	10.8	Sand brn blk, fine, clayey			
10.8	13.7	Sand, brn/blk, clayey			
13.7	26.5	Clay, blk, fine sandy			
26.5	27	Clay, blk, F-M sandy			
27	34	Sand, gy/blk, M-Cr			

7 CONTRACTOR'S OR LANDOWNER'S CERTIFICATION: This water well was **1** constructed, **2** reconstructed, or **3** plugged under my jurisdiction and was completed on (mo/day/year) **3-29-93** and this record is true to the best of my knowledge and belief. Kansas Water Well Contractor's License No. **527** This Water Well Record was completed on (mo/day/yr) **7-8-93** under the business name of **GeoCore Services, Inc.** by (signature) *Dale Rolley*