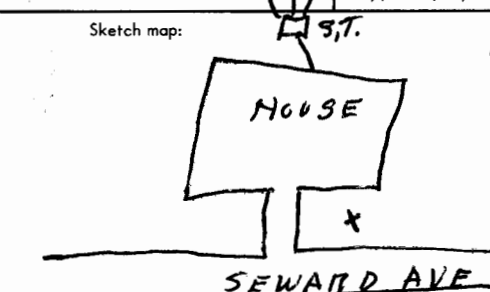


USE TYPEWRITER OR BALL POINT PEN—PRESS FIRMLY, PRINT CLEARLY.

WATER WELL RECORD
KSA 82a-1201-1215

Kansas Department of Health and Environment—Division of Environment
(Water well Contractors)
Topeka, Kansas 66620

1. Location of well:		County SHAWNEE	Fraction SE 1/4 SE 1/4 SE 1/4	Section number 27	Township number T 11 S R 16 E 11	Range number
2. Distance and direction from nearest town or city: IN CITY		3. Owner of well: MR. ANO		4. Street address of well location if in city: 2233 SEWARD AVE		
4. Locate with "X" in section below:		Sketch map: 		6. Bore hole dia. 5 in. Completion date 9-23-76 Well depth 45 ft.		
5. Type and color of material		From		To		7. <input type="checkbox"/> Cable tool <input type="checkbox"/> Rotary <input type="checkbox"/> Driven <input type="checkbox"/> Dug <input type="checkbox"/> Hollow rod <input type="checkbox"/> Jetted <input checked="" type="checkbox"/> Bored <input type="checkbox"/> Reverse rotary
TOP SOIL		0		6		8. Use: <input checked="" type="checkbox"/> Domestic <input type="checkbox"/> Public supply <input type="checkbox"/> Industry <input type="checkbox"/> Irrigation <input type="checkbox"/> Air conditioning <input type="checkbox"/> Stock <input type="checkbox"/> Lawn <input type="checkbox"/> Oil field water <input type="checkbox"/> Other
BROWN SILT		6		12		<input checked="" type="checkbox"/> Casing: Material <input type="checkbox"/> Height: Above or below Threaded <input type="checkbox"/> Welded <input type="checkbox"/> Surface 26 in. RMP STP PVC <input type="checkbox"/> Weight 7 lbs./ft. Dia. 5 in. to 45 ft. depth Wall Thickness: inches or Dia. <input type="checkbox"/> in. to <input type="checkbox"/> ft. depth gage No. 200
GRAY SILT + Sand		12		20		<input checked="" type="checkbox"/> Screen: Manufacturer's name SUNFLOWER Type STP Dia. 5" Slot/gauze 1/4" Length 5' Set between 2 1/4 ft. and 45 ft. ft. and BOTTOM ft. Gravel pack? <input checked="" type="checkbox"/> Size range of material 1/4"
BROWN " " "		20		30		11. Static water level: <input type="checkbox"/> mo./day/yr. 28 ft. below land surface Date 9-23-76
SAND AND GRAVEL		30		45		12. Pumping level below land surfaces: 28 ft. after 6 hrs. pumping 16 g.p.m. <input type="checkbox"/> ft. after <input type="checkbox"/> hrs. pumping <input type="checkbox"/> g.p.m. Estimated maximum yield 24 g.p.m.
						13. Water sample submitted: <input type="checkbox"/> mo./day/yr. Yes <input checked="" type="checkbox"/> No Date
						14. Well head completion: <input checked="" type="checkbox"/> Pitless adapter 12 Inches above grade
						15. Well grouted? <input checked="" type="checkbox"/> With: <input checked="" type="checkbox"/> Neat cement <input type="checkbox"/> Bentonite <input type="checkbox"/> Concrete Depth: From 3 ft. to 13 ft.
						16. Nearest source of possible contamination: ft. 20 Direction W Type GAS Well disinfected upon completion? <input checked="" type="checkbox"/> Yes <input type="checkbox"/> No
						17. Pump: <input type="checkbox"/> Not installed Manufacturer's name QUICK JACKETS Model number USED HP 1/2 Volts 115 Length of drop pipe 40 ft. capacity 8 g.p.m. Type: <input checked="" type="checkbox"/> Submersible <input type="checkbox"/> Turbine <input type="checkbox"/> Jet <input type="checkbox"/> Reciprocating <input type="checkbox"/> Centrifugal <input type="checkbox"/> Other
18. Elevation:		19. Remarks:		20. Water well contractor's certification: This well was drilled under my jurisdiction and this report is true to the best of my knowledge and belief. H. L. PETTIT 333 Business name 905 N. MICHIGAN License No. Address H. L. Pettit Day 10-1 Signed H. L. Pettit Authorized representative		

11 16W 27 SESESE 1/4 1/4 1/4