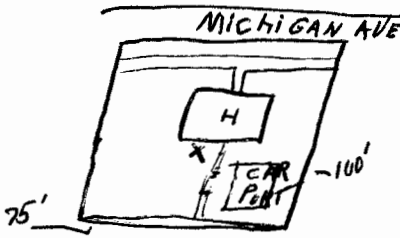


USE TYPEWRITER OR BALL POINT PEN-PRESS FIRMLY, PRINT CLEARLY.

WATER WELL RECORD
KSA 82a-1201-1215

ACA

Kansas Department of Health and Environment-Division of Environment
(Water well Contractors)
Topeka, Kansas 66620

1. Location of well:		County SHAWNEE	Fraction SW 1/4 SW 1/4 NE 1/4	Section number 28	Township number T 11 S R 16 E W	Range number
2. Distance and direction from nearest town or city: Street address of well location if in city: 905 N MICHIGAN			3. Owner of well: R.R. or street: City, state, zip code: H.L. PETTIT 905 N. MICHIGAN TOPEKA			
4. Locate with "X" in section below: N W E S 1 Mile		Sketch map: 		<input checked="" type="checkbox"/> Bore hole dia. 8 in. Completion date 8-28-76 Well depth 43 ft.		
5. Type and color of material		From	To	<input checked="" type="checkbox"/> Cable tool <input type="checkbox"/> Rotary <input type="checkbox"/> Driven <input type="checkbox"/> Dug <input type="checkbox"/> Hollow rod <input type="checkbox"/> Jetted <input checked="" type="checkbox"/> Bored <input type="checkbox"/> Reverse rotary		
Top Soil		0	5	8. Use: <input type="checkbox"/> Domestic <input type="checkbox"/> Public supply <input type="checkbox"/> Industry <input checked="" type="checkbox"/> Irrigation <input type="checkbox"/> Air conditioning <input type="checkbox"/> Stock <input type="checkbox"/> Lawn <input type="checkbox"/> Oil field water <input type="checkbox"/> Other		
HARD PAN		5	8	9. Casing: Material <input type="checkbox"/> Height: Above <input type="checkbox"/> Below Threaded <input type="checkbox"/> Welded <input type="checkbox"/> Surface 13 in. RMP <input checked="" type="checkbox"/> PVC <input type="checkbox"/> Weight <input type="checkbox"/> lbs./ft.		
BROWN SAND LOAM		8	16	Dia. 5 in. to 43 ft. depth Wall Thickness: inches or Dia. <input type="checkbox"/> in. to <input type="checkbox"/> ft. depth gage No. 200		
HARD PAN DARK GRAY		16	22	<input checked="" type="checkbox"/> Screen: Manufacturer's name SUNFLOWER		
SAND MUDD STREAKS		22	32	Type <input type="checkbox"/> Dia. <input type="checkbox"/> Slot/gauze 1/4 " Length 5 ' Set between 38 (ft.) and 43 (ft.) ft. and ft.		
SAND FINE		32	34	Gravel pack? <input checked="" type="checkbox"/> Size range of material 1/4 "		
" + GRAVEL		34	43	11. Static water level: mo./day/yr. 34 ' ft. below land surface Date 8-28-76		
				12. Pumping level below land surfaces: 34 ft. after 24 hrs. pumping 16 g.p.m. ft. after hrs. pumping g.p.m. Estimated maximum yield 25 g.p.m.		
				<input checked="" type="checkbox"/> Water sample submitted: mo./day/yr. Yes <input checked="" type="checkbox"/> No <input type="checkbox"/> Date		
				14. Well head completion: <input checked="" type="checkbox"/> Pitless adapter 13 Inches above grade		
				15. Well grouted? <input checked="" type="checkbox"/> With: <input checked="" type="checkbox"/> Neat cement <input type="checkbox"/> Bentonite <input type="checkbox"/> Concrete Depth: From 30 ' ft. to 10 ' ft.		
				16. Nearest source of possible contamination: IRON ft. 10 Direction S Type SEWER Well disinfected upon completion? <input checked="" type="checkbox"/> Yes <input type="checkbox"/> No		
				17. Pump: Not installed Manufacturer's name GOULDS Model number 724 HP 1/3 Volts 115 Length of drop pipe 39 ft. capacity 10 g.p.m. Type: <input checked="" type="checkbox"/> Submersible <input type="checkbox"/> Turbine <input type="checkbox"/> Jet <input type="checkbox"/> Reciprocating <input type="checkbox"/> Centrifugal <input type="checkbox"/> Other		
18. Elevation: 880 <i>Rm</i>		19. Remarks: WELL TERMINATION SLAB, 24" X 36" X 4" <i>H.L. Pettit</i>		20. Water well contractor's certification: This well was drilled under my jurisdiction and this report is true to the best of my knowledge and belief. H.L. PETTIT 333 Business name License No. Address 905 N MICHIGAN Signed H.L. Pettit Date 9-11-76 Authorized representative		

11-16E-28 SUS ONE