

USE TYPEWRITER OR BALL POINT PEN-PRESS FIRMLY, PRINT CLEARLY.

WATER WELL RECORD  
KSA 82a-1201-1215


Kansas Department of Health and Environment-Division of Environment (Water well Contractors) Topeka, Kansas 66620

SW-SW-NE

11S

1. Location of well: County Shawnee Fraction ~~NE NE SW~~ SW SW SW 1/4 1/4 Section 29 Township 11S Range number 16E  
T ~~11S~~ S R ~~16E~~ E/W

2. Distance and direction from nearest town or city: ~~4 1/2 miles~~ 501 Gordon  
Street address of well location if in city: Topeka, KS.  
3. Owner of well: Rosco Concrete  
R.R. or street: 501 Gordon  
City, state, zip code: Topeka, KS, 66608

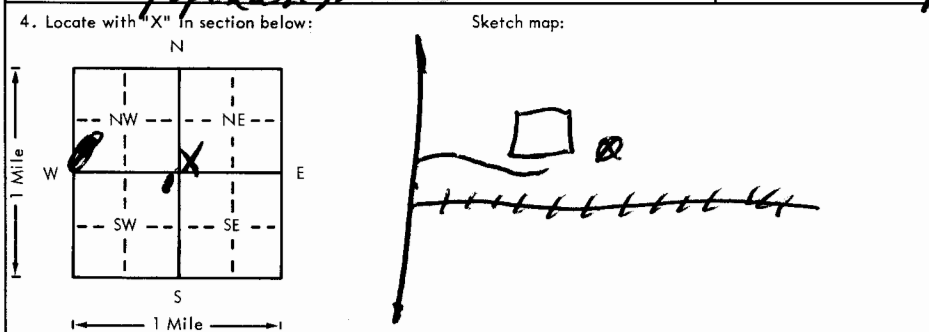

6. Bore hole dia. 8" in. Completion date 4-10-79  
Well depth 49 ft.

7.  Cable tool  Rotary  Driven  Dug  
 Hollow rod  Jetted  Bored  Reverse rotary

8. Use:  Domestic  Public supply  Industry  
 Irrigation  Air conditioning  Stock  
 Lawn  Oil field water  Other

9. Casing: Material Steel Height: Above or below  
Threaded  Welded  Surface 12" in.  
RMP  PVC  Weight 20.69 lbs./ft.  
Dia. 8 in. to 43 ft. depth Wall Thickness: inches or  
Dia.  in. to  ft. depth gage No. 025

5. Type and color of material	From	To
<u>Top Soil</u>	<u>0</u>	<u>2</u>
<u>Sandy loam</u>	<u>2</u>	<u>13</u>
<u>Sand Fine dirty</u>	<u>13</u>	<u>27</u>
<u>Sand-clay layers</u>	<u>27</u>	<u>40</u>
<u>Sand Fine-med</u>	<u>40</u>	<u>47</u>
<u>Sand med-coarse</u>	<u>47</u>	<u>49</u>

10. Screen: Manufacturer's name Johnson

Type Stain Steel Dia. 8"  
Slot/gauze  Length 7'  
Set between 42' ft. and 49' ft.  
ft. and  ft.  
Gravel pack? No Size range of material

11. Static water level:  mo./day/yr.  
19 ft. below land surface Date 4-10-79

12. Pumping level below land surfaces:  
 ft. after  hrs. pumping  g.p.m.  
 ft. after  hrs. pumping  g.p.m.  
Estimated maximum yield 100+ g.p.m.

13. Water sample submitted:  mo./day/yr.  
 Yes  No Date

14. Well head completion: Merrill 4'  
 Pitless well inches above grade

15. Well grouted? yes  
With:  Neat cement  Bentonite  Concrete  
Depth: From 0 ft. to 18 ft.

16. Nearest source of possible contamination:  
ft. 100 Direction North Type Fuel  
Well disinfected upon completion?  Yes  No

17. Pump:  Not installed  
Manufacturer's name Jacuzzi  
Model number 755651 HP 7 1/2 Volts 480  
Length of drop pipe 48 ft. capacity 100 g.p.m.  
Type:  
 Submersible  Turbine  
 Jet  Reciprocating  
 Centrifugal  Other

18. Elevation: 878 Rm  
Topography:  
 Hill  
 Slope  
 Upland  
 Valley

19. Remarks:

20. Water well contractor's certification:  
This well was drilled under my jurisdiction and this report is true to the best of my knowledge and belief.  
Robison Drilling 316  
Business name License No.  
Address Peru, KS  
Signed Jack Robison Date 4-10-79  
Authorized Representative

Forward the white, blue and pink copies to the Department of Health and Environment

Form WWC-5

T  
R  
W  
29  
1/4 1/4 1/4  
Sec