


1 LOCATION OF WATER WELL: Fraction $\frac{1}{4}$ SW $\frac{1}{4}$ SW $\frac{1}{4}$ Section Number 29 Township Number T 11 S Range Number R 16 **EW**
 County: SHAWNEE

Distance and direction from nearest town or city street address of well if located within city?
 110 E. Quincy

2 WATER WELL OWNER: South Eastern Public Service Company
 RR#, St. Address, Box #: 200 N. Kansas Board of Agriculture, Division of Water Resources
 City, State, ZIP Code: Topeka, KS Application Number: *none*

3 LOCATE WELL'S LOCATION WITH AN "X" IN SECTION BOX:

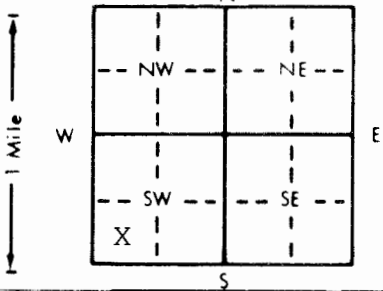

4 DEPTH OF COMPLETED WELL: 90 ft. ELEVATION:
 Depth(s) Groundwater Encountered 1. 40 ft. 2. ft. 3. ft.
 WELL'S STATIC WATER LEVEL 29'-6" ft. below land surface measured on mo/day/yr 4-29-88

Pump test data: Well water was ft. after hours pumping gpm
 Est. Yield 800 gpm: Well water was ft. after hours pumping gpm
 Bore Hole Diameter .15" in. to ft. and in. to ft.

WELL WATER TO BE USED AS:
 5 Public water supply 8 Air conditioning 11 Injection well
 1 Domestic 3 Feedlot 6 Oil field water supply 9 Dewatering 12 Other (Specify below)
 2 Irrigation 4 Industrial 7 Lawn and garden only 10 Observation well
 Was a chemical/bacteriological sample submitted to Department? Yes No **X** If yes, mo/day/yr sample was submitted Water Well Disinfected? Yes **X** No

5 TYPE OF BLANK CASING USED:
 1 Steel 3 RMP (SR) 5 Wrought iron 8 Concrete tile CASING JOINTS: Glued **X** Clamped
 2 PVC 4 ABS 6 Asbestos-Cement 9 Other (specify below) Welded
 7 Fiberglass Threaded

Blank casing diameter 10" in. to 0-80 ft. Dia in. to ft. Dia in. to ft.
 Casing height above land surface 24 in, weight 40 lbs. ft. Wall thickness or gauge No. 365

TYPE OF SCREEN OR PERFORATION MATERIAL:
 1 Steel 3 Stainless steel 5 Fiberglass 7 PVC 10 Asbestos-cement
 2 Brass 4 Galvanized steel 6 Concrete tile 8 RMP (SR) 11 Other (specify)
 12 None used (open hole)

SCREEN OR PERFORATION OPENINGS ARE:
 Johnson SS .100 5 Gauzed wrapped 8 Saw cut 11 None (open hole)
 1 Continuous slot 3 Mill slot 6 Wire wrapped 9 Drilled holes
 2 Louvered shutter 4 Key punched 7 Torch cut 10 Other (specify)

SCREEN-PERFORATED INTERVALS: From 80 ft. to 90 ft. From ft. to ft.
 From ft. to ft. From ft. to ft.
 GRAVEL PACK INTERVALS: From 30 ft. to 90 ft. From ft. to ft.
 From ft. to ft. From ft. to ft.

6 GROUT MATERIAL: 1 Neat cement 2 Cement grout 3 Bentonite 4 Other
 Grout Intervals: From 0 ft. to 30 ft. From ft. to ft. From ft. to ft.

What is the nearest source of possible contamination:
 1 Septic tank 4 Lateral lines 7 Pit privy 10 Livestock pens 14 Abandoned water well
 2 Sewer lines 5 Cess pool 8 Sewage lagoon 11 Fuel storage 15 Oil well/Gas well
 3 Watertight sewer lines 6 Seepage pit 9 Feedyard 12 Fertilizer storage 16 Other (specify below)
 13 Insecticide storage
 Direction from well? West How many feet? 110'

FROM	TO	LITHOLOGIC LOG	FROM	TO	LITHOLOGIC LOG
0	3	Top Soil			
3	23	Clay-Brown			
23	40	Fine Sand-Brown			
40	49	Fine Sand-Coarse Sand-Med-Pea Gravel, Brown			
49	51	Clay-Brown			
51	61	Fine Sand-Coarse Sand-Med-Pea gravel, Brown			
61	69	Fine Sand-Coarse Sand-Med-Brown			
69	87	Fine Sand-Coarse Sand-Med-Pea Gravel-Brown			
87	92	Chert Gravel 1/4x1/2 flat-grey			
92		Shale-Grey			

7 CONTRACTOR'S OR LANDOWNER'S CERTIFICATION: This water well was (1) constructed, (2) reconstructed, or (3) plugged under my jurisdiction and was completed on (mo/day/year) 4-29-88 and this record is true to the best of my knowledge and belief. Kansas Water Well Contractor's License No. 182 This Water Well Record was completed on (mo/day/yr) 5-6-88 under the business name of Strader Drilling co., Inc. by (signature) *Eric Strader*