


1 LOCATION OF WATER WELL: Fraction SE 1/4 SE 1/4 NW 1/4 Section Number 31 Township Number T 11 S Range Number R 16 EW

Distance and direction from nearest town or city street address of well if located within city?
1/2 mile east of Topeka

2 WATER WELL OWNER: Harry Busey
 RR#, St. Address, Box #: 125 Rice Road Board of Agriculture, Division of Water Resources
 City, State, ZIP Code: Topeka, KS 66607 Application Number:

3 LOCATE WELL'S LOCATION WITH AN "X" IN SECTION BOX: 4 DEPTH OF COMPLETED WELL: 50 ft. ELEVATION:

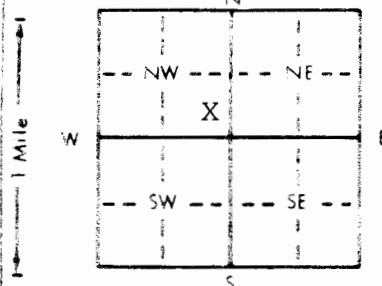

Depth(s) Groundwater Encountered: 1. 35 ft. 2. _____ ft. 3. _____ ft.
 WELL'S STATIC WATER LEVEL: 25' ft. below land surface measured on mo/day yr 12-23-88
 Pump test data: Well water was _____ ft. after _____ hours pumping _____ gpm
 Est. Yield: 50 gpm: Well water was _____ ft. after _____ hours pumping _____ gpm
 Bore Hole Diameter: 12" in. to _____ in. and _____ in. to _____ in.
 WELL WATER TO BE USED AS: 5 Public water supply 8 Air conditioning 11 Injection well
 1 Domestic 3 Feedlot 6 Oil field water supply 9 Dewatering 12 Other (Specify below)
 2 Irrigation 4 Industrial 7 Lawn and garden only 10 Monitoring well
 Was a chemical bacteriological sample submitted to Department? Yes _____ No X If yes, mo/day yr sample was submitted
 Water Well Disinfected? Yes X No _____

5 TYPE OF BLANK CASING USED: 5 Wrought iron 8 Concrete tile CASING JOINTS: Glued X Clamped _____
 1 Steel 3 RMP (SR) 6 Asbestos-Cement 9 Other (specify below) Welded _____
 2 PVC 4 ABS 7 Fiberglass Threaded _____

Blank casing diameter: 5" in. to 0-40 ft. Dia _____ in. to _____ ft. Dia _____ in. to _____ ft.
 Casing height above land surface: 24" in. weight 2.82 lbs./ft. Wall thickness or gauge No. .258

TYPE OF SCREEN OR PERFORATION MATERIAL: 7 PVC 10 Asbestos-cement
 1 Steel 3 Stainless steel 5 Fiberglass 8 RMP (SR) 11 Other (specify) _____
 2 Brass 4 Galvanized steel 6 Concrete tile 9 ABS 12 None used (open hole)

SCREEN OR PERFORATION OPENINGS ARE: 5 Gauzed wrapped 8 Saw cut 11 None (open hole)
 1 Continuous slot 3 Mill slot 6 Wire wrapped 9 Drilled holes
 2 Louvered shutter 4 Key punched 7 Torch cut 10 Other (specify) _____

SCREEN-PERFORATED INTERVALS: From 40 ft. to 50 ft. From _____ ft. to _____ ft.
 From _____ ft. to _____ ft. From _____ ft. to _____ ft.
 GRAVEL PACK INTERVALS: From 24 ft. to 50 ft. From _____ ft. to _____ ft.
 From _____ ft. to _____ ft. From _____ ft. to _____ ft.

6 GROUT MATERIAL: 1 Neat cement 2 Cement grout 3 Bentonite 4 Other _____
 Grout intervals: From 4 ft. to 24 ft. From _____ ft. to _____ ft. From _____ ft. to _____ ft.
 What is the nearest source of possible contamination: 10 Livestock pens 14 Abandoned water well
 1 Septic tank 4 Lateral lines 7 Pit privy 11 Fuel storage 15 Oil well/Gas well
 2 Sewer lines 5 Cess pool 8 Sewage lagoon 12 Fertilizer storage 16 Other (specify below)
 3 Watertight sewer lines 6 Seepage pit 9 Feedyard 13 Insecticide storage

Direction from well? S How many feet? 140

FROM	TO	LITHOLOGIC LOG	FROM	TO	PLUGGING INTERVALS
0	4	Top Soil			
4	25	Clay-Brown			
25	35	Fine Sand-Brown			
35	42	Fine Sand-Coarse Sand-Med Gravel,	Blue		
42	50	Fine Sand-Coarse Sand-Med Gravel,	Brown		

7 CONTRACTOR'S OR LANDOWNER'S CERTIFICATION: This water well was (1) constructed, (2) reconstructed, or (3) plugged under my jurisdiction and was completed on (mo/day/year) 12-23-88 and this record is true to the best of my knowledge and belief. Kansas Water Well Contractor's License No. 182 This Water Well Record was completed on (mo/day/yr) 2-6-89 under the business name of STRADER DRILLING CO., INC. by (signature) Valle Nelson