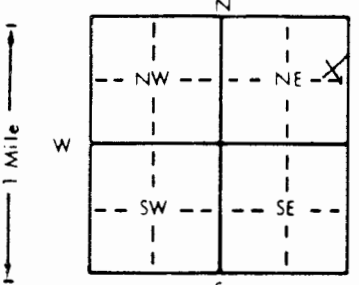


1 LOCATION OF WATER WELL: County: **Shawnee** Fraction: **SE 1/4 NE 1/4 NE 1/4** Section Number: **31** Township Number: **T 11 S** Range Number: **R 16 EW**

Distance and direction from nearest town or city street address of well if located within city?  
**215 S Quincy**

2 WATER WELL OWNER: **Mark Broxterman**  
 RR#, St. Address, Box #: **2910 E Topeka Ave.** Board of Agriculture, Division of Water Resources  
 City, State, ZIP Code: **Topeka, Ks. 66611** Application Number:

3 LOCATE WELL'S LOCATION WITH AN "X" IN SECTION BOX:  4 DEPTH OF COMPLETED WELL: **25** ft. ELEVATION: **891.44**  
 Depth(s) Groundwater Encountered: 1. **20** ft. 2. ft. 3. **6-8-93** ft.  
 WELL'S STATIC WATER LEVEL: **19.12** ft. below land surface measured on mo/day/yr  
 Pump test data: Well water was ft. after hours pumping gpm  
 Est. Yield gpm: Well water was ft. after hours pumping gpm  
 Bore Hole Diameter: **7 5/8** in. to **25** ft. and in. to ft.  
 WELL WATER TO BE USED AS:  
 5 Public water supply 8 Air conditioning 11 Injection well  
 1 Domestic 3 Feedlot 6 Oil field water supply 9 Dewatering 12 Other (Specify below)  
 2 Irrigation 4 Industrial 7 Lawn and garden only **10** Monitoring well  
 Was a chemical/bacteriological sample submitted to Department? Yes No **X**; If yes, mo/day/yr sample was submitted  
 Water Well Disinfected? Yes No **X**

5 TYPE OF BLANK CASING USED:  
 1 Steel 3 RMP (SR) 5 Wrought iron 8 Concrete tile CASING JOINTS: Glued Clamped  
**2** PVC 4 ABS 6 Asbestos-Cement 9 Other (specify below) Welded  
 7 Fiberglass Threaded **X**  
 Blank casing diameter: **2** in. to **15** ft., Dia in. to ft., Dia in. to ft.  
 Casing height above land surface: **38** in., weight lbs. ft. Wall thickness or gauge No. **Sch 40**  
 TYPE OF SCREEN OR PERFORATION MATERIAL:  
 1 Steel 3 Stainless steel 5 Fiberglass **7** PVC 10 Asbestos-cement  
 2 Brass 4 Galvanized steel 6 Concrete tile 8 RMP (SR) 11 Other (specify)  
 9 ABS 12 None used (open hole)  
 SCREEN OR PERFORATION OPENINGS ARE:  
 1 Continuous slot **3** Mill slot 5 Gauzed wrapped 8 Saw cut 11 None (open hole)  
 2 Louvered shutter 4 Key punched 6 Wire wrapped 9 Drilled holes  
 7 Torch cut 10 Other (specify)  
 SCREEN-PERFORATED INTERVALS: From **15** ft. to **25** ft., From ft. to ft.  
 From ft. to ft., From ft. to ft.  
 GRAVEL PACK INTERVALS: From **13** ft. to **25** ft., From ft. to ft.  
 From ft. to ft., From ft. to ft.

6 GROUT MATERIAL: 1 Neat cement **2** Cement grout **3** Bentonite 4 Other  
 Grout intervals: From **0** ft. to **11** ft., From **11** ft. to **13** ft., From ft. to ft.  
 What is the nearest source of possible contamination:  
 1 Septic tank 4 Lateral lines 7 Pit privy **10** Livestock pens 14 Abandoned water well  
 2 Sewer lines 5 Cess pool 8 Sewage lagoon **11** Fuel storage 15 Oil well/Gas well  
 3 Watertight sewer lines 6 Seepage pit 9 Feedyard 12 Fertilizer storage 16 Other (specify below)  
 13 Insecticide storage  
 Direction from well? **West** How many feet? **75**

FROM	TO	LITHOLOGIC LOG	FROM	TO	PLUGGING INTERVALS
0	4.4	Top soil, br/blk			
4.4	4.9	Clay, br/blk, fine sandy			MW 3
4.9	15.2	Clay, lt brn/brn, fine sandy			
15.2	18.5	Clay, brn/blk, sandy			
18.5	19.4	Sand, gy/blk, fine, clayey			
19.4	19.7	Clay, gy/blk, fine sandy			
19.7	25	Sand, gy/blk, fine, clayey			

7 CONTRACTOR'S OR LANDOWNER'S CERTIFICATION: This water well was **(1)** constructed, (2) reconstructed, or (3) plugged under my jurisdiction and was completed on (mo/day/year) **4-5-93** and this record is true to the best of my knowledge and belief. Kansas Water Well Contractor's License No. **527** This Water Well Record was completed on (mo/day/yr) **7-8-93** under the business name of **GeoCore Services, Inc.** by (signature) *Don Roll*