


mw-9

1 LOCATION OF WATER WELL: Fraction NE 1/4 SW 1/4 SE 1/4 Section Number 32 Township Number T 11 S Range Number R 16 EW
 County: Shawnee

Distance and direction from nearest town or city street address of well if located within city?
1320 SE 6th St

2 WATER WELL OWNER: Salvation Army
 RR#, St. Address, Box #: 1320 SE 6th St
 City, State, ZIP Code: Topeka, KS 66605
 Board of Agriculture, Division of Water Resources
 Application Number:

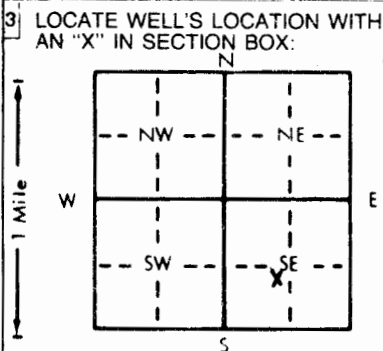

4 DEPTH OF COMPLETED WELL: 22.0 ft. ELEVATION:
 Depth(s) Groundwater Encountered 1. 19.6 ft. 2. - ft. 3. - ft.
 WELL'S STATIC WATER LEVEL: 13.40 ft. below land surface measured on mo/day/yr 5-10-94
 Pump test data: Well water was - ft. after - hours pumping - gpm
 Est. Yield - gpm: Well water was - ft. after - hours pumping - gpm
 Bore Hole Diameter: 8.625 in. to 22.0 ft., and - in. to - ft.
 WELL WATER TO BE USED AS:
 5 Public water supply 8 Air conditioning 11 Injection well
 1 Domestic 3 Feedlot 6 Oil field water supply 9 Dewatering 12 Other (Specify below)
 2 Irrigation 4 Industrial 7 Lawn and garden only 10 Monitoring well
 Was a chemical/bacteriological sample submitted to Department? Yes - No X; If yes, mo/day/yr sample was submitted -
 Water Well Disinfected? Yes - No X

5 TYPE OF BLANK CASING USED:
 1 Steel 3 RMP (SR) 5 Wrought iron 8 Concrete tile CASING JOINTS: Glued - Clamped -
 2 PVC 4 ABS 6 Asbestos-Cement 9 Other (specify below) Welded -
 7 Fiberglass Threaded X
 Blank casing diameter: 2 in. to 12 ft. Dia - in. to - ft. Dia - in. to - ft.
 Casing height above land surface: 24 in. weight sch 40 lbs./ft. Wall thickness or gauge No. -
 TYPE OF SCREEN OR PERFORATION MATERIAL:
 1 Steel 3 Stainless steel 5 Fiberglass 7 PVC 10 Asbestos-cement
 2 Brass 4 Galvanized steel 6 Concrete tile 9 ABS 11 Other (specify) -
 12 None used (open hole)
 SCREEN OR PERFORATION OPENINGS ARE:
 1 Continuous slot 3 Mill slot 5 Gauzed wrapped 8 Saw cut 11 None (open hole)
 2 Louvered shutter 4 Key punched 6 Wire wrapped 9 Drilled holes
 7 Torch cut 10 Other (specify) -
 SCREEN-PERFORATED INTERVALS: From 12 ft. to 22 ft. From - ft. to - ft. From - ft. to - ft.
 GRAVEL PACK INTERVALS: From 11.0 ft. to 22 ft. From - ft. to - ft. From - ft. to - ft.

6 GROUT MATERIAL:
 1 Neat cement 2 Cement grout 3 Bentonite 4 Other
 Grout Intervals: From GL ft. to 9.0 ft. From 9 ft. to 11 ft. From - ft. to - ft.
 What is the nearest source of possible contamination:
 1 Septic tank 4 Lateral lines 7 Pit privy 10 Livestock pens 14 Abandoned water well
 2 Sewer lines 5 Cess pool 8 Sewage lagoon 11 Fuel storage 15 Oil well/Gas well
 3 Watertight sewer lines 6 Seepage pit 9 Feedyard 12 Fertilizer storage 16 Other (specify below) Contaminated site
 13 Insecticide storage
 Direction from well? South How many feet? 200

FROM	TO	LITHOLOGIC LOG	FROM	TO	PLUGGING INTERVALS
GL	1	Soil silty clay, stiff dk grey Clayey silty firm to stiff, saturated sand stringer at 19.6 slight odor, grey to brown			
1	6.5				
6.5	22				
TD	22				

7 CONTRACTOR'S OR LANDOWNER'S CERTIFICATION: This water well was (1) constructed, (2) reconstructed, or (3) plugged under my jurisdiction and was completed on (mo/day/year) 04-12-94 and this record is true to the best of my knowledge and belief. Kansas Water Well Contractor's License No. 479 This Water Well Record was completed on (mo/day/yr) 05-24-94 under the business name of EBBERTS DRILLING by (signature) [Signature]

OFFICE USE ONLY

T

R

EW

SEC

1/4

1/4

1/4