


1 LOCATION OF WATER WELL: Fraction NE 1/4 NE 1/4 NE 1/4 Section Number 35 Township Number T 11 S Range Number R 16 E
 County: SHAWNEE
 Distance and direction from nearest town or city street address of well if located within city?

EAST TOPEKA SEWARD

2 WATER WELL OWNER: MR DAHLMAN Board of Agriculture, Division of Water Resources
 RR#, St. Address, Box #: 4105 SEWARD AVE Application Number:
 City, State, ZIP Code: TOPEKA, KAN. 66616

3 LOCATE WELL'S LOCATION WITH AN "X" IN SECTION BOX: 4 DEPTH OF COMPLETED WELL: 43 ft. ELEVATION:

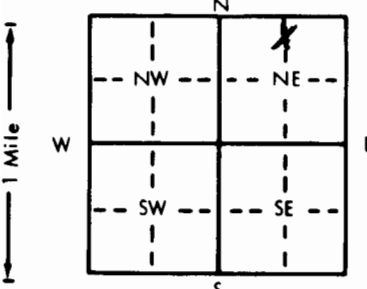

Depth(s) Groundwater Encountered 1. 22 ft. 2. 22 ft. 3. 22 ft.
 WELL'S STATIC WATER LEVEL 22 ft. below land surface measured on mo/day/yr
 Pump test data: Well water was 22 ft. after 1 hours pumping 16 gpm
 Est. Yield 30 gpm: Well water was 22 ft. after 1 hours pumping 16 gpm
 Bore Hole Diameter 8 in. to 23 ft., and 5 in. to 43 ft.
 WELL WATER TO BE USED AS: 5 Public water supply 8 Air conditioning 11 Injection well
 Domestic 3 Feedlot 6 Oil field water supply 9 Dewatering 12 Other (Specify below)
 2 Irrigation 4 Industrial 7 Lawn and garden only 10 Observation well
 Was a chemical/bacteriological sample submitted to Department? Yes No; If yes, mo/day/yr sample was submitted
 Water Well Disinfected? Yes Yes No

5 TYPE OF BLANK CASING USED: 5 Wrought iron 8 Concrete tile CASING JOINTS: Glued Clamped
 1 Steel 3 RMP (SR) 6 Asbestos-Cement 9 Other (specify below) Welded
 PVC 4 ABS 7 Fiberglass Threaded

 Casing height above land surface 16 in., weight 160 lbs./ft. Wall thickness or gauge No. 160

TYPE OF SCREEN OR PERFORATION MATERIAL: PVC 10 Asbestos-cement
 1 Steel 3 Stainless steel 5 Fiberglass 8 RMP (SR) 11 Other (specify)
 2 Brass 4 Galvanized steel 6 Concrete tile 9 ABS 12 None used (open hole)

SCREEN OR PERFORATION OPENINGS ARE: 5 Gauzed wrapped 8 Saw cut 11 None (open hole)
 1 Continuous slot Mill slot 6 Wire wrapped Drilled holes
 2 Louvered shutter 4 Key punched 7 Torch cut 10 Other (specify)


6 GROUT MATERIAL: Neat cement 2 Cement grout 3 Bentonite 4 Other

What is the nearest source of possible contamination: Septic tank Lateral lines 7 Pit privy 10 Livestock pens 14 Abandoned water well
 2 Sewer lines 5 Cess pool 8 Sewage lagoon 11 Fuel storage 15 Oil well/Gas well
 3 Watertight sewer lines 6 Seepage pit 9 Feedyard 12 Fertilizer storage 16 Other (specify below)
 13 Insecticide storage

Direction from well? How many feet? 40

FROM	TO	LITHOLOGIC LOG	FROM	TO	LITHOLOGIC LOG
0	4	01 Top Soil			
4	8	02 BROWN SILT			
8	22	03 SAND + SILT			
22	32	05 SAND			
32	43	17 SAND + GRAVEL			

7 CONTRACTOR'S OR LANDOWNER'S CERTIFICATION: This water well was (1) constructed, (2) reconstructed, or (3) plugged under my jurisdiction and was completed on (mo/day/year) 9-18-84 and this record is true to the best of my knowledge and belief. Kansas Water Well Contractor's License No. 333. This Water Well Record was completed on (mo/day/yr) 9-21-84 under the business name of H.L. PETTIT by (signature) H.L. Pettit

INSTRUCTIONS: Use typewriter or ball point pen, PLEASE PRESS FIRMLY and PRINT clearly. Please fill in blanks, underline or circle the correct answers. Send top three copies to Kansas Department of Health and Environment, Division of Environment, Environmental Geology Section, Topeka, KS 66620. Send one to WATER WELL OWNER and retain one for your records.

OFFICE USE ONLY
T
R
16
EW
SEC.
35
C
1/4
N
1/4
NE
1/4