


1 LOCATION OF WATER WELL: County: **SHAWNEE** Fraction: **NW 1/4 NE 1/4 NE 1/4** Section Number: **35** Township Number: **T 11 S** Range Number: **R 16 EW**  
 Distance and direction from nearest town or city street address of well if located within city?  
**4035 SEWARD AVE**

2 WATER WELL OWNER: **D. WILSON**  
 RR#, St. Address, Box #: **8126 SE HWY 40 TECUMSEH** Board of Agriculture, Division of Water Resources  
 City, State, ZIP Code: **TOPEKA KAN. 66607** Application Number:

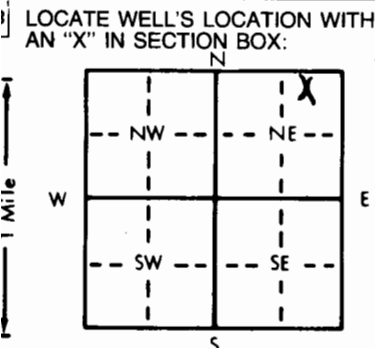

4 DEPTH OF COMPLETED WELL: **35** ft. ELEVATION:  
 WELL'S STATIC WATER LEVEL: **18** ft. below land surface measured on mo/day/yr **3/31/84**  
 Pump test data: Well water was **18** ft. after **1** hours pumping **18** gpm  
 Est. Yield: **40** gpm: Well water was **18** ft. after **1** hours pumping **18** gpm  
 Bore Hole Diameter: **8** in. to **18** ft. and **5** in. to **35** ft.  
 WELL WATER TO BE USED AS:  
 1 Domestic  2 Irrigation  3 Feedlot  4 Industrial  5 Public water supply  6 Oil field water supply  7 Lawn and garden only  8 Air conditioning  9 Dewatering  10 Observation well  11 Injection well  12 Other (Specify below)  
 Was a chemical/bacteriological sample submitted to Department? Yes  No  If yes, mo/day/yr sample was submitted  
 Water Well Disinfected? Yes  No

5 TYPE OF BLANK CASING USED:  
 1 Steel  2 Brass  3 RMP (SR)  4 Galvanized steel  5 Fiberglass  6 Concrete tile  7 Other (specify below)  
 2 PVC  4 ABS  7 Fiberglass  
 Casing height above land surface: **2.4** in., weight **160** lbs./ft. Wall thickness or gauge No. **160**

TYPE OF SCREEN OR PERFORATION MATERIAL:  
 1 Steel  2 Brass  3 Stainless steel  4 Galvanized steel  5 Fiberglass  6 Concrete tile  7 PVC  8 RMP (SR)  9 ABS  10 Asbestos-cement  11 Other (specify)  12 None used (open hole)

SCREEN OR PERFORATION OPENINGS ARE:  
 1 Continuous slot  2 Louvered shutter  3 Mill slot  4 Key punched  5 Gauzed wrapped  6 Wire wrapped  7 Torch cut  8 Saw cut  9 Drilled holes  10 Other (specify)  11 None (open hole)


6 GROUT MATERIAL:  1 Neat cement  2 Cement grout  3 Bentonite  4 Other  

What is the nearest source of possible contamination:  
 1 Septic tank  2 Sewer lines  3 Watertight sewer lines  4 Lateral lines  5 Cess pool  6 Seepage pit  7 Pit privy  8 Sewage lagoon  9 Feedyard  10 Livestock pens  11 Fuel storage  12 Fertilizer storage  13 Insecticide storage  14 Abandoned water well  15 Oil well/Gas well  16 Other (specify below)  
 Direction from well? **80 - IN FUTURE**

FROM	TO	LITHOLOGIC LOG	FROM	TO	LITHOLOGIC LOG
0	4	02 SILT			
4	6	01 HARD PAN			
6	10	03 " " + SILT			
10	18	07 FINE SAND			
18	35	17 SAND GRAVEL			

7 CONTRACTOR'S OR LANDOWNER'S CERTIFICATION: This water well was (1) constructed, (2) reconstructed, or (3) plugged under my jurisdiction and was completed on (mo/day/year) **3/31/84** and this record is true to the best of my knowledge and belief. Kansas Water Well Contractor's License No. **333** This Water Well Record was completed on (mo/day/yr) **4/2/84** under the business name of **H. L. PETTIT** by (signature) *H. L. Pettit*

INSTRUCTIONS: Use typewriter or ball point pen, PLEASE PRESS FIRMLY and PRINT clearly. Please fill in blanks, underline or circle the correct answers. Send top three copies to Kansas Department of Health and Environment, Division of Environment, Environmental Geology Section, Topeka, KS 66620. Send one to WATER WELL OWNER and retain one for your records.

OFFICE USE ONLY  
T  
R  
16  
EW  
SEC.  
35  
ALPHA  
NE 1/4  
NE 1/4