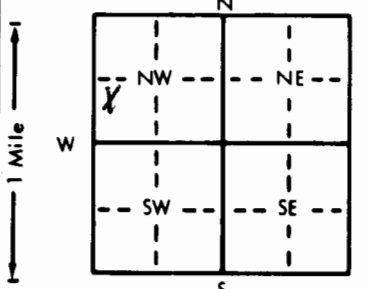


1 LOCATION OF WATER WELL: Fraction NE 1/4 SW 1/4 NW 1/4 Section Number 35 Township Number T 11 S Range Number R 16 EW
 County: Shawnee

Distance and direction from nearest town or city street address of well if located within city?
3/4 N of 40 Hiway on Croco Rd.

2 WATER WELL OWNER: George Champney
 RR#, St. Address, Box # :
 City, State, ZIP Code : 3224 NE Seward Ave, Topeka, Kans Board of Agriculture, Division of Water Resources
 Application Number:

3 LOCATE WELL'S LOCATION WITH AN "X" IN SECTION BOX:

 4 DEPTH OF COMPLETED WELL: 36 ft. ELEVATION:
 Depth(s) Groundwater Encountered 1. 13' ft. 2. ft. 3. ft.
 WELL'S STATIC WATER LEVEL 9' ft. below land surface measured on mo/day/yr April 23 1988
 Pump test data: Well water was ft. after hours pumping gpm
 Est. Yield gpm: Well water was ft. after hours pumping gpm
 Bore Hole Diameter 8" in. to 36 ft., and in. to ft.
 WELL WATER TO BE USED AS:
 5 Public water supply 8 Air conditioning 11 Injection well
 1 Domestic 3 Feedlot 6 Oil field water supply 9 Dewatering 12 Other (Specify below)
 2 Irrigation 4 Industrial 7 Lawn and garden only 10 Observation well Monitoring
 Was a chemical/bacteriological sample submitted to Department? Yes No X; If yes, mo/day/yr sample was submitted
 Water Well Disinfected? Yes No X

5 TYPE OF BLANK CASING USED:
 1 Steel 3 RMP (SR) 5 Wrought iron 8 Concrete tile CASING JOINTS: Glued NO Clamped
 2 PVC 4 ABS 6 Asbestos-Cement 9 Other (specify below) Welded
 7 Fiberglass Treated Rivet
 Blank casing diameter 5 in. to 36 ft., Dia in. to ft., Dia in. to ft.
 Casing height above land surface 1 1/2' in., weight lbs./ft. Wall thickness or gauge No. SPR 26
 TYPE OF SCREEN OR PERFORATION MATERIAL:
 1 Steel 3 Stainless steel 5 Fiberglass 8 RMP (SR) 10 Asbestos-cement
 2 Brass 4 Galvanized steel 6 Concrete tile 9 ABS 11 Other (specify)
 12 None used (open hole)
 SCREEN OR PERFORATION OPENINGS ARE:
 1 Continuous slot 3 Mill slot 5 Gauzed wrapped 8 Saw cut 11 None (open hole)
 2 Louvered shutter 4 Key punched 6 Wire wrapped 9 Drilled holes
 7 Torch cut 10 Other (specify)
 SCREEN-PERFORATED INTERVALS: From 36 ft. to 36 ft., From ft. to ft.
 From ft. to ft., From ft. to ft.
 GRAVEL PACK INTERVALS: From None ft. to ft., From ft. to ft.
 From ft. to ft., From ft. to ft.

6 GROUT MATERIAL: 1 Heat cement 2 Cement grout 3 Bentonite 4 Other
 Grout intervals: From 0 ft. to 20' ft., From ft. to ft., From ft. to ft.
 What is the nearest source of possible contamination:
 1 Septic tank 4 Lateral lines 7 Pit privy 10 Livestock pens 14 Abandoned water well
 2 Sewer lines 5 Cess pool 8 Sewage lagoon 11 Fuel storage 15 Oil well/Gas well
 3 Watertight sewer lines 6 Seepage pit 9 Feedyard 12 Fertilizer storage 16 Other (specify below)
 13 Insecticide storage unknown
 Direction from well? How many feet?

| FROM | TO | LITHOLOGIC LOG | FROM | TO | LITHOLOGIC LOG |
|-----------|-----------|------------------------|------|----|--|
| <u>0</u> | <u>13</u> | <u>loamy clay</u> | | | <u>Well #1 - deep hole at East end of head pit</u> |
| <u>13</u> | <u>32</u> | <u>Med. Sand</u> | | | |
| <u>32</u> | <u>36</u> | <u>Clay sand mixed</u> | | | |
| <u>36</u> | | <u>Bed rock.</u> | | | |

7 CONTRACTOR'S OR LANDOWNER'S CERTIFICATION: This water well was (1) constructed, (2) reconstructed, or (3) plugged under my jurisdiction and was completed on (mo/day/year) April 23, 1988 and this record is true to the best of my knowledge and belief. Kansas Water Well Contractor's License No. 316 This Water Well Record was completed on (mo/day/yr) 6-26-88 under the business name of Robison Drilling by (signature) Jack Robison

OFFICE USE ONLY
T
R
EW
SEC.
1/4
1/4
1/4