


1 LOCATION OF WATER WELL: County: SHAWNEE Fraction: SE 1/4 SE 1/4 NW 1/4 Section Number: 28 Township Number: T 11 S Range Number: R 16 E/W

Distance and direction from nearest town or city street address of well if located within city?
PERRY AUTO - 800 CHESTER ST. TOPEKA KS

2 WATER WELL OWNER: CITY OF TOPEKA - ATT GREG SCHELL
 RR#, St. Address, Box #: 515 S. KS. AVE - HDZ - TOPEKA KS. 66603 Board of Agriculture, Division of Water Resources
 City, State, ZIP Code: Application Number:

3 LOCATE WELL'S LOCATION WITH AN "X" IN SECTION BOX:

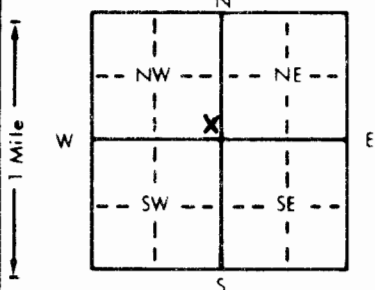

4 DEPTH OF COMPLETED WELL: 35 ft. ELEVATION:
 Depth(s) Groundwater Encountered 1. 26.5 ft. 2. - ft. 3. - ft.
 WELL'S STATIC WATER LEVEL: 27.2 ft. below land surface measured on mo/day/yr 07-15-94

Pump test data: Well water was - ft. after - hours pumping - gpm
 Est. Yield - gpm Well water was - ft. after - hours pumping - gpm
 Bore Hole Diameter: 8.25 in. to 35 ft. and - in. to - ft.
 WELL WATER TO BE USED AS:
 1 Domestic - 3 Feedlot - 6 Oil field water supply - 9 Dewatering - 12 Other (Specify below)
 2 Irrigation - 4 Industrial - 7 Lawn and garden only - 10 Monitoring well -
 Was a chemical/bacteriological sample submitted to Department? Yes - No X If yes, mo/day/yr sample was submitted
 Water Well Disinfected? Yes - No X

5 TYPE OF BLANK CASING USED:
 1 Steel - 3 RMP (SR) - 5 Wrought iron - 8 Concrete tile - CASING JOINTS: Glued - Clamped -
 2 PVC - 4 ABS - 6 Asbestos-Cement - 9 Other (specify below) - Welded -
 Blank casing diameter: 2 in. to 18.3 ft. Dia. - in. to - ft. Dia. - in. to - ft.
 Casing height above land surface: FLUSH 0 in. weight SOFT 40 lbs./ft. Wall thickness or gauge No. -
 TYPE OF SCREEN OR PERFORATION MATERIAL:
 1 Steel - 3 Stainless steel - 5 Fiberglass - 7 PVC - 10 Asbestos-cement -
 2 Brass - 4 Galvanized steel - 6 Concrete tile - 8 RMP (SR) - 11 Other (specify) -
 3 None used (open hole) -

SCREEN OR PERFORATION OPENINGS ARE:
 1 Continuous slot - 3 Mill slot - 5 Gauzed wrapped - 8 Saw cut - 11 None (open hole)
 2 Louvered shutter - 4 Key punched - 6 Wire wrapped - 9 Drilled holes -
 7 Torch cut - 10 Other (specify) -

SCREEN-PERFORATED INTERVALS: From 18.3 ft. to 33.3 ft. From - ft. to - ft.
 From - ft. to - ft. From - ft. to - ft.
 From - ft. to - ft. From - ft. to - ft.
 SAND GRAVEL PACK INTERVALS: From 17.3 ft. to 35 ft. From - ft. to - ft.
 From - ft. to - ft. From - ft. to - ft.

6 GROUT MATERIAL: 1 Neat cement - 2 Cement grout - 3 Bentonite - 4 Other -
 Grout Intervals: From 6L ft. to 15.3 ft. From 15.3 ft. to 12.3 ft. From - ft. to - ft.

What is the nearest source of possible contamination:
 1 Septic tank - 4 Lateral lines - 7 Pit privy - 10 Livestock pens - 14 Abandoned water well -
 2 Sewer lines - 5 Cess pool - 8 Sewage lagoon - 11 Fuel storage - 15 Oil well/Gas well -
 3 Watertight sewer lines - 6 Seepage pit - 9 Feedyard - 12 Fertilizer storage - 16 Other (specify below) -
 13 Insecticide storage - TKS - REMOVED
 Direction from well? CONTAMINATED SITE
 How many feet? CONTAMINATED SITE

FROM	TO	LITHOLOGIC LOG	FROM	TO	PLUGGING INTERVALS
6L	3	SOIL			
3	10	CLAY SILT			
10	20	SILTY SAND			
20	25	SAND			
25	28	SILTY SAND			
28	35	SAND			
TD	35				

FLUSH MOUNT WAIVER
DON TAYLOR 07-18-94

7 CONTRACTOR'S OR LANDOWNER'S CERTIFICATION: This water well was (1) constructed, (2) reconstructed, or (3) plugged under my jurisdiction and was completed on (mo/day/year) 07-14-94 and this record is true to the best of my knowledge and belief. Kansas Water Well Contractor's License No. 479 This Water Well Record was completed on (mo/day/yr) 08-12-94 under the business name of EBBERTS DRILLING by (signature) Greg Ebberts

OFFICE USE ONLY