


1 LOCATION OF WATER WELL: Fraction SE 1/4 SE 1/4 NW 1/4 Section Number 28 Township Number T 11 S Range Number R 16 E/W
 County: SHAWNEE

Distance and direction from nearest town or city street address of well if located within city?
PERRY AUTO - 800 CHESTER ST. TOPEKA

2 WATER WELL OWNER: CITY OF TOPEKA - ATT: GREG SCHELL
 RR#, St. Address, Box #: 515 S-KS. AVE. #402-TOPEKA KS - 66603 Board of Agriculture, Division of Water Resources
 City, State, ZIP Code: 515 S-KS. AVE. #402-TOPEKA KS - 66603 Application Number:

3 LOCATE WELL'S LOCATION WITH AN "X" IN SECTION BOX:

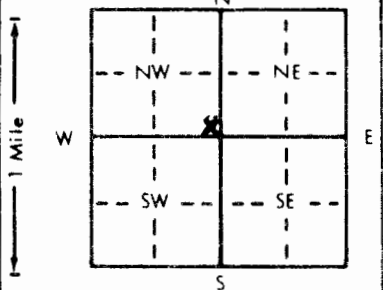

4 DEPTH OF COMPLETED WELL: 35 ft. ELEVATION:
 Depth(s) Groundwater Encountered 1. 26.5 ft. 2. - ft. 3. - ft.
 WELL'S STATIC WATER LEVEL 27.2 ft. below land surface measured on mo/day/yr 07-15-94
 Pump test data: Well water was - ft. after - hours pumping - gpm
 Est. Yield - gpm: Well water was - ft. after - hours pumping - gpm
 Bore Hole Diameter 8 1/2 in. to 35 ft., and - in. to - ft.

WELL WATER TO BE USED AS:
 1 Domestic 3 Feedlot 6 Oil field water supply 9 Dewatering 12 Other (Specify below)
 2 Irrigation 4 Industrial 7 Lawn and garden only 10 Monitoring well
 Was a chemical/bacteriological sample submitted to Department? Yes - No X; If yes, mo/day/yr sample was submitted -
 Water Well Disinfected? Yes - No X

5 TYPE OF BLANK CASING USED:
 1 Steel 3 RMP (SR) 5 Wrought iron 8 Concrete tile CASING JOINTS: Glued - Clamped -
 2 PVC 4 ABS 6 Asbestos-Cement 9 Other (specify below) Welded -
 7 Fiberglass Threaded X

Blank casing diameter 2 in. to 18.3 ft. Dia. - in. to - ft. Dia. - in. to - ft.
 Casing height above land surface FLUSH in. weight SC4 40 lbs./ft. Wall thickness or gauge No. -

TYPE OF SCREEN OR PERFORATION MATERIAL:
 1 Steel 3 Stainless steel 5 Fiberglass 7 PVC 10 Asbestos-cement
 2 Brass 4 Galvanized steel 6 Concrete tile 8 RMP (SR) 11 Other (specify)
 9 ABS 12 None used (open hole)

SCREEN OR PERFORATION OPENINGS ARE:
 1 Continuous slot 3 Mill slot 5 Gauzed wrapped 8 Saw cut 11 None (open hole)
 2 Louvered shutter 4 Key punched 7 Torch cut 9 Drilled holes 10 Other (specify) -

SCREEN-PERFORATED INTERVALS: From 18.3 ft. to 33.3 ft., From - ft. to - ft., From - ft. to - ft.
 From - ft. to - ft., From - ft. to - ft., From - ft. to - ft.
 SAND SCREEN PACK INTERVALS: From 17.3 ft. to 35 ft., From - ft. to - ft., From - ft. to - ft.
 From - ft. to - ft., From - ft. to - ft., From - ft. to - ft.

6 GROUT MATERIAL: 1 Neat cement 2 Cement grout 3 Bentonite 4 Other -
 Grout Intervals: From 6L ft. to 15.3 ft., From 15.3 ft. to 17.3 ft., From - ft. to - ft.

What is the nearest source of possible contamination:
 1 Septic tank 4 Lateral lines 7 Pit privy 10 Livestock pens 14 Abandoned water well
 2 Sewer lines 5 Cess pool 8 Sewage lagoon 11 Fuel storage 15 Oil well/Gas well
 3 Watertight sewer lines 6 Seepage pit 9 Feedyard 12 Fertilizer storage 16 Other (specify below)
 13 Insecticide storage TKS-REMOVED
 Direction from well? - How many feet? CONTAMINATED SITE

| FROM | TO | LITHOLOGIC LOG | FROM | TO | PLUGGING INTERVALS |
|--|----|----------------|------|----|--------------------|
| 6L | 3 | SOIL | | | |
| 3 | 10 | CLAY SILT | | | |
| 10 | 20 | SILTY SAND | | | |
| 20 | 25 | SAND | | | |
| 25 | 28 | SILTY SAND | | | |
| 28 | 35 | SAND | | | |
| TO | 35 | | | | |
| <p><u>FLUSH MOUNT WAIVER</u> <u>DON TAYLOR 07-18-94</u></p> | | | | | |

7 CONTRACTOR'S OR LANDOWNER'S CERTIFICATION: This water well was (1) constructed, (2) reconstructed, or (3) plugged under my jurisdiction and was completed on (mo/day/year) 07-14-94 and this record is true to the best of my knowledge and belief. Kansas Water Well Contractor's License No. 477 This Water Well Record was completed on (mo/day/yr) 08-12-94 under the business name of EBBERTS DRILLING by (signature) Gregory Ebberts