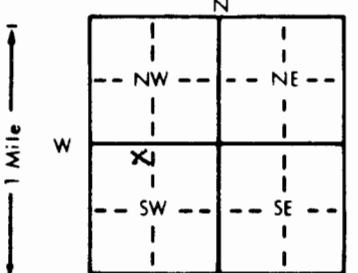


1 LOCATION OF WATER WELL: County: SHAWNEE Fraction: NE 1/4 NW 1/4 SW 1/4 Section Number: 20 Township Number: T 11 S Range Number: R 16 E

Distance and direction from nearest town or city street address of well if located within city?
AT ADDRESS BELOW MW # 7

2 WATER WELL OWNER: HAROLD ROLLEY TRUST
 RR#, St. Address, Box #: 2100 SE 29th
 City, State, ZIP Code: TOPEKA, KS 66605
 Board of Agriculture, Division of Water Resources
 Application Number:

3 LOCATE WELL'S LOCATION WITH AN "X" IN SECTION BOX:

 4 DEPTH OF COMPLETED WELL: 32 ft. ELEVATION: 881.88
 Depth(s) Groundwater Encountered 1. 25 ft. 2. _____ ft. 3. _____ ft.
 WELL'S STATIC WATER LEVEL: 25 ft. below land surface measured on mo/day/yr 8/2/94
 Pump test data: Well water was _____ ft. after _____ hours pumping _____ gpm
 Est. Yield _____ gpm: Well water was _____ ft. after _____ hours pumping _____ gpm
 Bore Hole Diameter: 8 1/2 in. to 32 in. and _____ in. to _____ in.
 WELL WATER TO BE USED AS:
 1 Domestic 3 Feedlot 5 Public water supply 8 Air conditioning 11 Injection well
 2 Irrigation 4 Industrial 6 Oil field water supply 9 Dewatering 12 Other (Specify below)
 7 Lawn and garden only 10 Monitoring well
 Was a chemical/bacteriological sample submitted to Department? Yes _____ No (No); If yes, mo/day/yr sample was submitted _____
 Water Well Disinfected? Yes _____ No (No)

5 TYPE OF BLANK CASING USED:
 1 Steel 3 RMP (SR) 5 Wrought iron 8 Concrete tile CASING JOINTS: Glued _____ Clamped _____
(2) PVC 4 ABS 6 Asbestos-Cement 9 Other (specify below) Welded
 7 Fiberglass Threaded
 Blank casing diameter 2 in. to 22 ft. Dia _____ in. to _____ ft. Dia _____ in. to _____ ft.
 Casing height above land surface _____ in. weight _____ lbs./ft. Wall thickness or gauge No. SC# 40
 TYPE OF SCREEN OR PERFORATION MATERIAL:
 1 Steel 3 Stainless steel 5 Fiberglass 8 RMP (SR) 10 Asbestos-cement
 2 Brass 4 Galvanized steel 6 Concrete tile 9 ABS 11 Other (specify) _____
 12 None used (open hole)
 SCREEN OR PERFORATION OPENINGS ARE:
 1 Continuous slot 3 Mill slot 5 Gauzed wrapped 8 (8) Saw cut 1010 11 None (open hole)
 2 Louvered shutter 4 Key punched 6 Wire wrapped 9 Drilled holes
 7 Torch cut 10 Other (specify) _____
 SCREEN-PERFORATED INTERVALS: From 22 ft. to 32 ft. From _____ ft. to _____ ft.
 GRAVEL PACK INTERVALS: From 21 ft. to 32 ft. From _____ ft. to _____ ft.

6 GROUT MATERIAL: 1 Neat cement 2 (2) Cement grout 3 (3) Bentonite 4 Other _____
 Grout Intervals: From 0 ft. to 2 ft. From 2 ft. to 21 ft. From _____ ft. to _____ ft.
 What is the nearest source of possible contamination:
 1 Septic tank 4 Lateral lines 7 Pit privy 10 Livestock pens 14 Abandoned water well
 2 Sewer lines 5 Cess pool 8 Sewage lagoon 11 Fuel storage 15 Oil well/Gas well
 3 Watertight sewer lines 6 Seepage pit 9 Feedyard 12 Fertilizer storage 16 Other (specify below)
 13 Insecticide storage
 Direction from well? ON SITE How many feet?

FROM	TO	LITHOLOGIC LOG	FROM	TO	PLUGGING INTERVALS
<u>0</u>	<u>1</u>	<u>TOPSOIL</u>			
<u>1</u>	<u>6.5</u>	<u>SILTY LT. BROWN CLAY</u>			
<u>6.5</u>	<u>7.5</u>	<u>SANDY LT. BROWN CLAY</u>			
<u>7.5</u>	<u>22</u>	<u>SILTY BROWN CLAY</u>			
<u>22</u>	<u>32</u>	<u>SAND, TAN-BROWN, FGR-CGR</u>			

7 CONTRACTOR'S OR LANDOWNER'S CERTIFICATION: This water well was (1) constructed, (2) reconstructed, or (3) plugged under my jurisdiction and was completed on (mo/day/year) 8/2/94 and this record is true to the best of my knowledge and belief. Kansas Water Well Contractor's License No. 554 This Water Well Record was completed on (mo/day/yr) 9/25 under the business name of AGD SERVICES INC. by (signature) Heidi Green