


1 LOCATION OF WATER WELL: County: **SHAWNEE** Fraction: **NE 1/4 NE 1/4 NW 1/4** Section Number: **20** Township Number: **T 11 S** Range Number: **R 16 EW**

Distance and direction from nearest town or city street address of well if located within city?
At the southeast intersection of N Topeka Blvd. and Lyman Road

2 WATER WELL OWNER: **Resolution Trust Corporation as Receiver for United Federal Savings of Iowa**
 RR#, St. Address, Box #: **4900 Main Street, Suite 200** Board of Agriculture, Division of Water Resources
 City, State, ZIP Code: **Kansas City, Missouri 64112** Application Number:

3 LOCATE WELL'S LOCATION WITH AN "X" IN SECTION BOX:

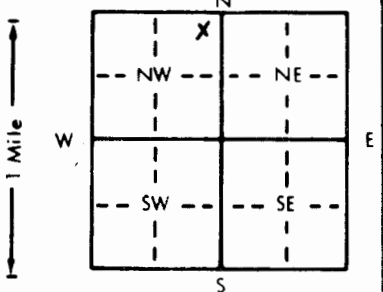

4 DEPTH OF COMPLETED WELL: **30'** ft. ELEVATION:
 Depth(s) Groundwater Encountered 1. **21'** ft. 2. ft. 3. ft.
 WELL'S STATIC WATER LEVEL **21'** ft. below land surface measured on mo/day/yr
 Pump test data: Well water was ft. after hours pumping gpm
 Est. Yield gpm: Well water was ft. after hours pumping gpm
 Bore Hole Diameter in. to ft., and in. to ft.
 WELL WATER TO BE USED AS:
 5 Public water supply 8 Air conditioning 11 Injection well
 1 Domestic 3 Feedlot 6 Oil field water supply 9 Dewatering 12 Other (Specify below)
 2 Irrigation 4 Industrial 7 Lawn and garden only **10** Monitoring well
 Was a chemical/bacteriological sample submitted to Department? Yes No **X**; If yes, mo/day/yr sample was submitted
 Water Well Disinfected? Yes No **X**

5 TYPE OF BLANK CASING USED:
 1 Steel 3 RMP (SR) 5 Wrought iron 8 Concrete tile CASING JOINTS: Glued Clamped
2 PVC 4 ABS 6 Asbestos-Cement 9 Other (specify below) Welded
 7 Fiberglass Threaded
 Blank casing diameter **2** in. to **10** ft., Dia. in. to ft., Dia. in. to ft.
 Casing height above land surface in., weight lbs./ft. Wall thickness or gauge No.

TYPE OF SCREEN OR PERFORATION MATERIAL:
 1 Steel 3 Stainless steel 5 Fiberglass **7** PVC 10 Asbestos-cement
 2 Brass 4 Galvanized steel 6 Concrete tile 8 RMP (SR) 11 Other (specify)
 9 ABS 12 None used (open hole)

SCREEN OR PERFORATION OPENINGS ARE:
 1 Continuous slot **3** Mill slot 5 Gauzed wrapped 8 Saw cut 11 None (open hole)
 2 Louvered shutter 4 Key punched 6 Wire wrapped 9 Drilled holes
 7 Torch cut 10 Other (specify)

SCREEN-PERFORATED INTERVALS: From **30** ft. to **20** ft., From ft. to ft.
 From ft. to ft., From ft. to ft.
 GRAVEL PACK INTERVALS: From **30** ft. to **8** ft., From ft. to ft.
 From ft. to ft., From ft. to ft.

6 GROUT MATERIAL: 1 Neat cement 2 Cement grout **3** Bentonite 4 Other
 Grout Intervals: From **8** ft. to **6** ft., From ft. to ft., From ft. to ft.
 What is the nearest source of possible contamination:
 1 Septic tank 4 Lateral lines 7 Pit privy **11** Fuel storage 14 Abandoned water well
 2 Sewer lines 5 Cess pool 8 Sewage lagoon 12 Fertilizer storage 15 Oil well/Gas well
 3 Watertight sewer lines 6 Seepage pit 9 Feedyard 13 Insecticide storage 16 Other (specify below)
 Direction from well? How many feet?

FROM	TO	LITHOLOGIC LOG	FROM	TO	PLUGGING INTERVALS
0	12	BAN SILTY CLAY TAN SAND			
12	30				
MW-5					

7 CONTRACTOR'S OR LANDOWNER'S CERTIFICATION: This water well was **(1)** constructed, (2) reconstructed, or (3) plugged under my jurisdiction and was completed on (mo/day/year) **11-19-94** and this record is true to the best of my knowledge and belief. Kansas Water Well Contractor's License No. **568A** This Water Well Record was completed on (mo/day/yr) **11-19-94** under the business name of **MAX'S ENTERPRISES** by (signature) **David Huxville**