


1 LOCATION OF WATER WELL: County: SHAWNEE Fraction: NE 1/4 NE 1/4 NW 1/4 Section Number: 20 Township Number: T 11 S Range Number: R 16 EW

Distance and direction from nearest town or city street address of well if located within city?
At the southeast intersection of N. Topeka Blvd. and Lyman Rd.

2 WATER WELL OWNER: Resolution Trust Corporation as Receiver for United Federal Savings Association of Iowa
 RR#, St. Address, Box #: 4900 Main Street, suite 200 Board of Agriculture, Division of Water Resources
 City, State, ZIP Code: Kansas City, Missouri 64112 Application Number:

3 LOCATE WELL'S LOCATION WITH AN "X" IN SECTION BOX:

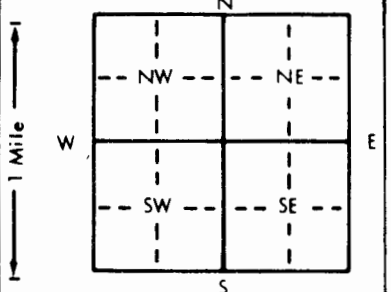

4 DEPTH OF COMPLETED WELL: 30' ft. ELEVATION: ft.
 Depth(s) Groundwater Encountered: 1 20' ft. 2. ft. 3. ft.
 WELL'S STATIC WATER LEVEL: 20' ft. below land surface measured on mo/day/yr
 Pump test data: Well water was ft. after hours pumping gpm
 Est. Yield gpm: Well water was ft. after hours pumping gpm
 Bore Hole Diameter: 8 in. to 30 ft., and in. to ft.
 WELL WATER TO BE USED AS:
 5 Public water supply 8 Air conditioning 11 Injection well
 1 Domestic 3 Feedlot 6 Oil field water supply 9 Dewatering 12 Other (Specify below)
 2 Irrigation 4 Industrial 7 Lawn and garden only 10 Monitoring well
 Was a chemical/bacteriological sample submitted to Department? Yes..... No X; If yes, mo/day/yr sample was submitted
 Water Well Disinfected? Yes No X

5 TYPE OF BLANK CASING USED:
 1 Steel 3 RMP (SR) 5 Wrought iron 8 Concrete tile CASING JOINTS: Glued Clamped
 2 PVC 4 ABS 6 Asbestos-Cement 9 Other (specify below) Welded
 7 Fiberglass Threaded.....
 Blank casing diameter: 2" in. to 10' ft., Dia in. to ft., Dia in. to ft.
 Casing height above land surface: 0 in., weight lbs./ft. Wall thickness or gauge No.
 TYPE OF SCREEN OR PERFORATION MATERIAL:
 1 Steel 3 Stainless steel 5 Fiberglass 8 RMP (SR) 10 Asbestos-cement
 2 Brass 4 Galvanized steel 6 Concrete tile 9 ABS 11 Other (specify)
 12 None used (open hole)
 SCREEN OR PERFORATION OPENINGS ARE:
 1 Continuous slot 2 Mill slot 5 Gauzed wrapped 8 Saw cut 11 None (open hole)
 2 Louvered shutter 4 Key punched 6 Wire wrapped 9 Drilled holes
 7 Torch cut 10 Other (specify)
 SCREEN-PERFORATED INTERVALS: From 30' ft. to 10' ft., From ft. to ft.
 From ft. to ft., From ft. to ft.
 GRAVEL PACK INTERVALS: From 30' ft. to 8' ft., From ft. to ft.
 From ft. to ft., From ft. to ft.

6 GROUT MATERIAL: 1 Neat cement 2 Cement grout 3 Bentonite 4 Other
 Grout intervals: From 8 ft. to 6 ft., From ft. to ft., From ft. to ft.
 What is the nearest source of possible contamination:
 1 Septic tank 4 Lateral lines 7 Pit privy 1 Fuel storage 14 Abandoned water well
 2 Sewer lines 5 Cess pool 8 Sewage lagoon 12 Fertilizer storage 15 Oil well/Gas well
 3 Watertight sewer lines 6 Seepage pit 9 Feedyard 13 Insecticide storage 16 Other (specify below)
 Direction from well? How many feet?

FROM	TO	LITHOLOGIC LOG	FROM	TO	PLUGGING INTERVALS
<u>0</u>	<u>11</u>	<u>BEN SILTY CLAY</u>			
<u>11</u>	<u>30</u>	<u>TAN SAND</u>			
<u>MW-2</u>					

7 CONTRACTOR'S OR LANDOWNER'S CERTIFICATION: This water well was (1) constructed, (2) reconstructed, or (3) plugged under my jurisdiction and was completed on (mo/day/year) 11-18-94 and this record is true to the best of my knowledge and belief. Kansas Water Well Contractor's License No. 568 A This Water Well Record was completed on (mo/day/yr) 11-18-94 under the business name of Max's Enterprises by (signature) David Hume