


mw-1

1 LOCATION OF WATER WELL: Fraction NE 1/4 NW 1/4 SE 1/4 Section Number 31 Township Number T 11 S Range Number R 16 EW
 County: Shawnee
 Distance and direction from nearest town or city street address of well if located within city?
701 Jackson, Topeka, KS

2 WATER WELL OWNER: Insurance Bldg C/O Columbia Natl Bank, Kathy Heslet
 RR#, St. Address, Box #: 701 Kansas Ave Board of Agriculture, Division of Water Resources
 City, State, ZIP Code: Topeka, KS 66603 Application Number:

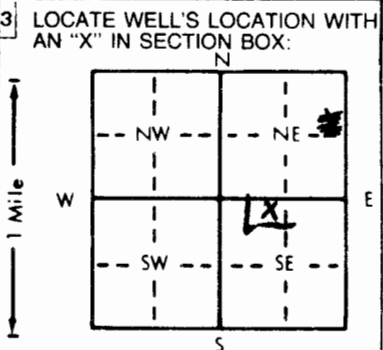

4 DEPTH OF COMPLETED WELL 10.5 ft. ELEVATION:
 Depth(s) Groundwater Encountered 1. 6.5 ft. 2. ft. 3. ft.
 WELL'S STATIC WATER LEVEL 3.76 ft. below land surface measured on mo/day/yr 1-26-95
 Pump test data: Well water was ft. after hours pumping gpm
 Est. Yield gpm: Well water was ft. after hours pumping gpm
 Bore Hole Diameter 8.625 in. to 10.5 ft., and in. to ft.
 WELL WATER TO BE USED AS:
 5 Public water supply 8 Air conditioning 11 Injection well
 1 Domestic 3 Feedlot 6 Oil field water supply 9 Dewatering 12 Other (Specify below)
 2 Irrigation 4 Industrial 7 Lawn and garden only 10 Monitoring well mw-1
 Was a chemical/bacteriological sample submitted to Department? Yes No X If yes, mo/day/yr sample was submitted
 Water Well Disinfected? Yes No X

5 TYPE OF BLANK CASING USED:
 1 Steel 3 RMP (SR) 5 Wrought iron 8 Concrete tile CASING JOINTS: Glued Clamped
2 PVC 4 ABS 6 Asbestos-Cement 9 Other (specify below) Welded
 7 Fiberglass Threaded X
 Blank casing diameter 2 in. to 5.5 ft., Dia in. to ft., Dia in. to ft.
 Casing height above land surface 0 in., weight Sch. 40 PVC lbs./ft. Wall thickness or gauge No.
 TYPE OF SCREEN OR PERFORATION MATERIAL:
 1 Steel 3 Stainless steel 5 Fiberglass 7 PVC 10 Asbestos-cement
 2 Brass 4 Galvanized steel 6 Concrete tile 9 ABS 11 Other (specify)
 12 None used (open hole)
 SCREEN OR PERFORATION OPENINGS ARE:
 1 Continuous slot 3 Mill slot 5 Gauzed wrapped 8 Saw cut 11 None (open hole)
 2 Louvered shutter 4 Key punched 6 Wire wrapped 9 Drilled holes
 7 Torch cut 10 Other (specify)
 SCREEN-PERFORATED INTERVALS: From 5.5 ft. to 10.5 ft., From ft. to ft., From ft. to ft.
SAND From ft. to ft., From ft. to ft., From ft. to ft.
 GRAVEL PACK INTERVALS: From 4 ft. to 10.5 ft., From ft. to ft., From ft. to ft.
 From ft. to ft., From ft. to ft., From ft. to ft.

6 GROUT MATERIAL:
 1 Neat cement 2 Cement grout 3 Bentonite 4 Other
 Grout Intervals: From 0 ft. to 2 ft., From 2 ft. to 4 ft., From ft. to ft., From ft. to ft.
 What is the nearest source of possible contamination:
 1 Septic tank 4 Lateral lines 7 Pit privy 11 Fuel storage 14 Abandoned water well
 2 Sewer lines 5 Cess pool 8 Sewage lagoon 12 Fertilizer storage 15 Oil well/Gas well
 3 Watertight sewer lines 6 Seepage pit 9 Feedyard 13 Insecticide storage 16 Other (specify below)
Contaminated site
 Direction from well? How many feet?

FROM	TO	LITHOLOGIC LOG	FROM	TO	PLUGGING INTERVALS
0	0.3'	Asphalt			
0.3'	6.5'	Fill, silty clay			
6.5'	10.0'	shale, weathered			
10.0'	10.5'	Limestone			
10.5'	TD	END OF BOREHOLE			

Flush mount waiver
 1-12-95
 D. Taylor

7 CONTRACTOR'S OR LANDOWNER'S CERTIFICATION: This water well was (1) constructed, (2) reconstructed, or (3) plugged under my jurisdiction and was completed on (mo/day/year) 1-25-95 and this record is true to the best of my knowledge and belief. Kansas Water Well Contractor's License No. 585 This Water Well Record was completed on (mo/day/yr) 2-21-95 under the business name of Associated Environmental, Inc by (signature) D. Johnson for David Duncan

OFFICE USE ONLY