


MW-2

1 LOCATION OF WATER WELL: 089 Fraction SE NE NW Section Number 27 Township Number T 11 S Range Number R 16 E/N
 County: Shawnee

Distance and direction from nearest town or city street address of well if located within city?
Billard Airport, Topeka, KS

2 WATER WELL OWNER: metropolitan Topeka Airport Authority Attn. D. Stremming
 RR#, St. Address, Box #: Box 19053, Topeka, KS 66619
 Board of Agriculture, Division of Water Resources
 City, State, ZIP Code: _____ Application Number: _____

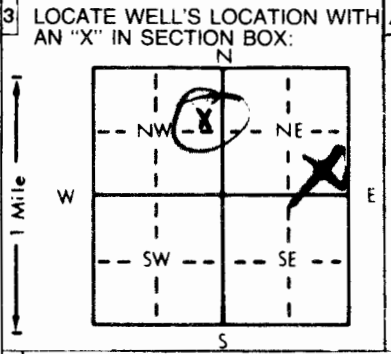

4 DEPTH OF COMPLETED WELL: 35 ft. ELEVATION: 879.18
 Depth(s) Groundwater Encountered 1. 25.6 ft. 2. ~~25.6~~ ft. 3. _____ ft.
 WELL'S STATIC WATER LEVEL: 27.13 ft. below land surface measured on mo/day/yr 1-19-95
 Pump test data: Well water was _____ ft. after _____ hours pumping _____ gpm
 Est. Yield _____ gpm Well water was _____ ft. after _____ hours pumping _____ gpm
 Bore Hole Diameter: 8.625 in. to 35 ft. and _____ in. to _____ ft.
 WELL WATER TO BE USED AS:
 5 Public water supply 8 Air conditioning 11 Injection well
 1 Domestic 3 Feedlot 6 Oil field water supply 9 Dewatering 12 Other (Specify below)
 2 Irrigation 4 Industrial 7 Lawn and garden only 10 Monitoring well MW-2
 Was a chemical/bacteriological sample submitted to Department? Yes _____ No X If yes, mo/day/yr sample was submitted _____
 Water Well Disinfected? Yes _____ No X

5 TYPE OF BLANK CASING USED:
 1 Steel 3 RMP (SR) 5 Wrought iron 8 Concrete tile CASING JOINTS: Glued _____ Clamped _____
2 PVC 4 ABS 6 Asbestos-Cement 9 Other (specify below) Welded _____
 7 Fiberglass _____ Threaded X
 Blank casing diameter 2 in. to 18 ft., Dia _____ in. to _____ ft., Dia _____ in. to _____ ft.
 Casing height above land surface 24 in., weight Sch 40 PVC lbs./ft. Wall thickness or gauge No. _____
 TYPE OF SCREEN OR PERFORATION MATERIAL:
 1 Steel 3 Stainless steel 5 Fiberglass 7 PVC 10 Asbestos-cement
 2 Brass 4 Galvanized steel 6 Concrete tile 9 ABS 11 Other (specify) _____
 12 None used (open hole)
 SCREEN OR PERFORATION OPENINGS ARE:
 1 Continuous slot 3 Mill slot 5 Gauzed wrapped 8 Saw cut 11 None (open hole)
 2 Louvered shutter 4 Key punched 6 Wire wrapped 9 Drilled holes
 7 Torch cut 10 Other (specify) _____
 SCREEN-PERFORATED INTERVALS: From 18 ft. to 33 ft., From _____ ft. to _____ ft.
SAND From _____ ft. to _____ ft., From _____ ft. to _____ ft.
 GRAVEL PACK INTERVALS: From 17 ft. to 35 ft., From _____ ft. to _____ ft.
 From _____ ft. to _____ ft., From _____ ft. to _____ ft.

6 GROUT MATERIAL: 2 Neat cement 2 Cement grout 3 Bentonite 4 Other _____
 Grout Intervals From GL ft. to 15 ft., From 15 ft. to 17 ft., From _____ ft. to _____ ft.
 What is the nearest source of possible contamination:
 1 Septic tank 4 Lateral lines 7 Pit privy 11 Fuel storage 14 Abandoned water well
 2 Sewer lines 5 Cess pool 8 Sewage lagoon 12 Fertilizer storage 15 Oil well/Gas well
 3 Watertight sewer lines 6 Seepage pit 9 Feedyard 13 Insecticide storage 16 Other (specify below)
contaminated site
 Direction from well? _____ How many feet? _____

FROM	TO	LITHOLOGIC LOG	FROM	TO	PLUGGING INTERVALS
<u>GL</u>	<u>1.5</u>	<u>Fill, ls gravel</u>			
<u>1.5</u>	<u>13.0</u>	<u>clayey silt</u>			
<u>13.0</u>	<u>19.0</u>	<u>sandy silt</u>			
<u>19.0</u>	<u>24.0</u>	<u>clayey silt</u>			
<u>24.0</u>	<u>35.0</u>	<u>silty sand</u>			
<u>35.0</u>	<u>TD</u>	<u>END OF BOREHOLE.</u>			

Flush mount waiver
11-28-94 D. Taylor

7 CONTRACTOR'S OR LANDOWNER'S CERTIFICATION: This water well was (1) constructed, (2) reconstructed, or (3) plugged under my jurisdiction and was completed on (mo/day/year) 1-10-95 and this record is true to the best of my knowledge and belief. Kansas Water Well Contractor's License No. 585 This Water Well Record was completed on (mo/day/yr) 2-6-95 under the business name of Associated Environmental, Inc by (signature) Dee Johnson for Daru Duncanson

OFFICE USE ONLY
T
R
EW
SEC