


mw-1 mTA

1 LOCATION OF WATER WELL: Fraction SE NE NW Section Number 27 Township Number T 11 S Range Number R 16 E
 County: Shawnee

Distance and direction from nearest town or city street address of well if located within city?
Billard Airport, Topeka, KS

2 WATER WELL OWNER: Metropolitan Topeka Airport Authority ATTN: D. Stremming
 RR#, St. Address, Box #: P.O. Box 19053 Board of Agriculture, Division of Water Resources
 City, State, ZIP Code: Topeka, KS 66619 Application Number: 1-19-95

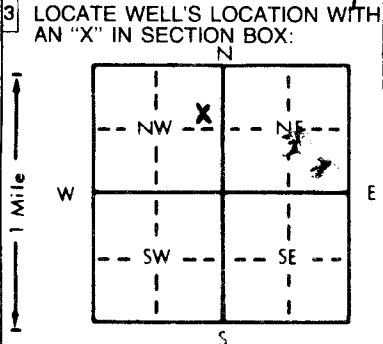

4 DEPTH OF COMPLETED WELL: 38.0 ft. ELEVATION: 880.00
 Depth(s) Groundwater Encountered 1. 28.7 ft. 2. — ft. 3. — ft.
 WELL'S STATIC WATER LEVEL 27.98 ft. below land surface measured on mo/day/yr 1-19-95
 Pump test data: Well water was — ft. after — hours pumping — gpm
 Est. Yield — gpm: Well water was — ft. after — hours pumping — gpm
 Bore Hole Diameter: 8.625 in. to 38.0 ft., and — in. to — ft.
 WELL WATER TO BE USED AS:
 5 Public water supply 8 Air conditioning 11 Injection well
 1 Domestic 3 Feedlot 6 Oil field water supply 9 Dewatering 12 Other (Specify below)
 2 Irrigation 4 Industrial 7 Lawn and garden only 10 Monitoring well
 Was a chemical/bacteriological sample submitted to Department? Yes — No X If yes, mo/day/yr sample was submitted —
 Water Well Disinfected? Yes — No X

5 TYPE OF BLANK CASING USED:
 1 PVC 3 RMP (SR) 5 Wrought iron 8 Concrete tile CASING JOINTS: Glued — Clamped —
 2 — 4 ABS 6 Asbestos-Cement 9 Other (specify below) Welded —
 Blank casing diameter 2 in. to 21.25 ft., Dia — in. to — ft., Dia — in. to — ft.
 Casing height above land surface: 0 in., weight Sch 40 Ayc lbs./ft. Wall thickness or gauge No. —
 TYPE OF SCREEN OR PERFORATION MATERIAL:
 1 Steel 3 Stainless steel 5 Fiberglass 8 RMP (SR) 10 Asbestos-cement
 2 Brass 4 Galvanized steel 6 Concrete tile 9 ABS 11 Other (specify) —
 12 None used (open hole)
 SCREEN OR PERFORATION OPENINGS ARE:
 1 Continuous slot 2 3 Mill slot 5 Gauzed wrapped 8 Saw cut 11 None (open hole)
 2 Louvered shutter 4 Key punched 6 Wire wrapped 9 Drilled holes
 7 Torch cut 10 Other (specify) —
 SCREEN-PERFORATED INTERVALS: From 21.25 ft. to 36.25 ft., From — ft. to — ft.
 From — ft. to — ft., From — ft. to — ft.
 SAND GRAVEL PACK INTERVALS: From 20.25 ft. to 38.0 ft., From — ft. to — ft.
 From — ft. to — ft., From — ft. to — ft.

6 GROUT MATERIAL:
 1 Neat cement 2 Cement grout 3 Bentonite 4 Other —
 Grout Intervals: From GL ft. to 18.25 ft., From 18.25 ft. to 20.25 ft., From — ft. to — ft.
 What is the nearest source of possible contamination:
 1 Septic tank 4 Lateral lines 7 Pit privy 10 Livestock pens 14 Abandoned water well
 2 Sewer lines 5 Cess pool 8 Sewage lagoon 11 Fuel storage 15 Oil well/Gas well
 3 Watertight sewer lines 6 Seepage pit 9 Feedyard 12 Fertilizer storage 16 Other (specify below)
contaminated site
 Direction from well? How many feet?

| FROM | TO | LITHOLOGIC LOG | FROM | TO | PLUGGING INTERVALS |
|------|-------|-----------------|------|----|--------------------|
| 0 | 1.5' | Fill, gravel | | | |
| 1.5 | 7.0' | clayey silt | | | |
| 7.0 | 18.0' | sandy silt | | | |
| 18.0 | 23.5' | clayey silt | | | |
| 23.5 | 28.5' | sandy silt | | | |
| 28.5 | 38.0' | Sand | | | |
| 38.0 | TD | END OF BOREHOLE | | | |

Flush mount waiver
11-28-94 D. Taylor.

7 CONTRACTOR'S OR LANDOWNER'S CERTIFICATION: This water well was (1) constructed, (2) reconstructed, or (3) plugged under my jurisdiction and was completed on (mo/day/year) 1-10-95 and this record is true to the best of my knowledge and belief. Kansas Water Well Contractor's License No. 585 This Water Well Record was completed on (mo/day/yr) 2-6-95 under the business name of Associated Environmental, Inc. by (signature) Dee Johnson for Dawn Duncan

OFFICE USE ONLY