


MW-4 MTA

1 LOCATION OF WATER WELL: 089 Fraction NE NW Section Number 27 Township Number T 11 S Range Number R 16 E  
 County: Shawnee

Distance and direction from nearest town or city street address of well if located within city?  
Billard Airport, Topeka, KS

2 WATER WELL OWNER: metropolitan Topeka Airport Authority Attn: D. Stremming  
 RR#, St. Address, Box #: Box 19053, Topeka, KS 66619 Board of Agriculture, Division of Water Resources  
 City, State, ZIP Code: Application Number:           

3 LOCATE WELL'S LOCATION WITH AN "X" IN SECTION BOX:

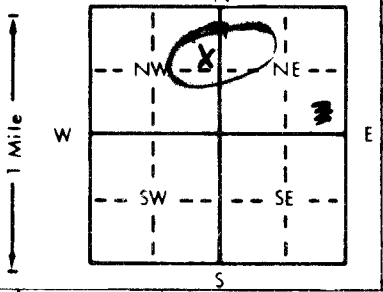

4 DEPTH OF COMPLETED WELL: 35 ft. ELEVATION: 879.59

Depth(s) Groundwater Encountered 1. 26.5 ft. 2.            ft. 3.            ft.  
 WELL'S STATIC WATER LEVEL 28.02 ft. below land surface measured on mo/day/yr 1-19-95  
 Pump test data: Well water was            ft. after            hours pumping            gpm  
 Est. Yield            gpm: Well water was            ft. after            hours pumping            gpm  
 Bore Hole Diameter: 8.625 in. to 35 ft. and            in. to            ft.  
 WELL WATER TO BE USED AS:  
 5 Public water supply 8 Air conditioning 11 Injection well  
 1 Domestic 3 Feedlot 6 Oil field water supply 9 Dewatering 12 Other (Specify below)  
 2 Irrigation 4 Industrial 7 Lawn and garden only 10 Monitoring well MW-4  
 Was a chemical/bacteriological sample submitted to Department? Yes            No X; If yes, mo/day/yr sample was submitted             
 Water Well Disinfected? Yes            No X

5 TYPE OF BLANK CASING USED:  
 1 Steel 3 RMP (SR) 5 Wrought iron 8 Concrete tile CASING JOINTS: Glued            Clamped             
 2 PVC 4 ABS 6 Asbestos-Cement 9 Other (specify below) Welded             
 7 Fiberglass Threaded X

Blank casing diameter 2 in. to 20 ft. Dia            in. to            ft. Dia            in. to            ft.  
 Casing height above land surface 0 in. weight Sch. 40 PVC lbs./ft. Wall thickness or gauge No.           

TYPE OF SCREEN OR PERFORATION MATERIAL:  
 1 Steel 3 Stainless steel 5 Fiberglass 8 RMP (SR) 10 Asbestos-cement 11 Other (specify)             
 2 Brass 4 Galvanized steel 6 Concrete tile 9 ABS 12 None used (open hole)

SCREEN OR PERFORATION OPENINGS ARE:  
 1 Continuous slot 3 Mill slot 5 Gauzed wrapped 8 Saw cut 11 None (open hole)  
 2 Louvered shutter 4 Key punched 6 Wire wrapped 9 Drilled holes  
 7 Torch cut 10 Other (specify)           

SCREEN-PERFORATED INTERVALS: From 20 ft. to 35 ft. From            ft. to            ft.  
 From            ft. to            ft. From            ft. to            ft.  
 SAND GRAVEL PACK INTERVALS: From 19 ft. to 35 ft. From            ft. to            ft.  
 From            ft. to            ft. From            ft. to            ft.

6 GROUT MATERIAL:  
 1 Neat cement 2 GL 3 Cement grout 4 Other             
 Grout Intervals: From GL ft. to 17 ft. From 17 ft. to 19 ft. From            ft. to            ft.

What is the nearest source of possible contamination:  
 1 Septic tank 4 Lateral lines 7 Pit privy 10 Livestock pens 14 Abandoned water well  
 2 Sewer lines 5 Cess pool 8 Sewage lagoon 11 Fuel storage 15 Oil well/Gas well  
 3 Watertight sewer lines 6 Seepage pit 9 Feedyard 12 Fertilizer storage 16 Other (specify below)  
contaminated site  
 Direction from well? How many feet?           

FROM	TO	LITHOLOGIC LOG	FROM	TO	PLUGGING INTERVALS
<u>GL</u>	<u>1.0</u>	<u>Fill, gravel and silts, clays</u>			
<u>1.0</u>	<u>14.5</u>	<u>clayey silt</u>			
<u>14.5</u>	<u>17.5</u>	<u>silty sand</u>			
<u>17.5</u>	<u>21.0</u>	<u>clayey silt</u>			
<del>21.0</del>	<del>30.0</del>	<del>silty sand</del>			
<del>30.0</del>	<del>35.0</del>	<del>END OF BOREHOLE</del>			
<u>21.0</u>	<u>30.2</u>	<u>silty sand</u>			
<u>30.2</u>	<u>35.0</u>	<u>Sand</u>			
<u>35.0</u>	<u>TD</u>	<u>END OF BOREHOLE</u>			

Flush mount  
 Waiver 11-28-94  
 D. Taylor

7 CONTRACTOR'S OR LANDOWNER'S CERTIFICATION: This water well was (1) constructed, (2) reconstructed, or (3) plugged under my jurisdiction and was completed on (mo/day/year) 1-11-95 and this record is true to the best of my knowledge and belief. Kansas Water Well Contractor's License No. 2585 This Water Well Record was completed on (mo/day/yr) 2-6-95 under the business name of Associated Environmental, Inc by (signature) Dee Johnson for Darin D...