


DAW 5 MTA

1 LOCATION OF WATER WELL: County: Shawnee 89 Fraction: NE 1/4 Section Number: 27 Township Number: T 11 S Range Number: R 16 E/W

Distance and direction from nearest town or city street address of well if located within city?  
Billard Airport

2 WATER WELL OWNER: METROPOLITAN TOPEKA AIRPORT AUTHORITY ATTN: D. STREMMING  
RR#, St. Address, Box #: P.O. BOX 19053, TOPEKA, KS 66619 Board of Agriculture, Division of Water Resources  
City, State, ZIP Code: Application Number: -

3 LOCATE WELL'S LOCATION WITH AN "X" IN SECTION BOX:

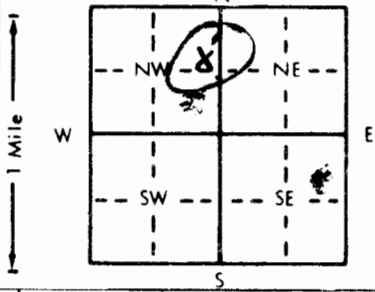

4 DEPTH OF COMPLETED WELL: 34 ft. ELEVATION: 877.71

Depth(s) Groundwater Encountered: 1. 25.3 ft. 2. -- ft. 3. -- ft.  
WELL'S STATIC WATER LEVEL: 25.97 ft. below land surface measured on mo/day/yr 1-19-95  
Pump test data: Well water was -- ft. after -- hours pumping -- gpm  
Est. Yield -- gpm: Well water was -- ft. after -- hours pumping -- gpm  
Bore Hole Diameter: 8.625 in. to 34 ft. and -- in. to -- ft.  
WELL WATER TO BE USED AS:  
5 Public water supply 8 Air conditioning 11 Injection well  
1 Domestic 3 Feedlot 6 Oil field water supply 9 Dewatering 12 Other (Specify below)  
2 Irrigation 4 Industrial 7 Lawn and garden only 10 Monitoring well MW-5  
Was a chemical/bacteriological sample submitted to Department? Yes -- No X; If yes, mo/day/yr sample was submitted --  
Water Well Disinfected? Yes -- No X

5 TYPE OF BLANK CASING USED:  
1 Steel 3 RMP (SR) 5 Wrought iron 8 Concrete tile CASING JOINTS: Glued -- Clamped --  
2 PVC 4 ABS 6 Asbestos-Cement 9 Other (specify below) Welded --  
7 Fiberglass Threaded X

Blank casing diameter: 2 in. to 19 ft. Dia. -- in. to -- ft. Dia. -- in. to -- ft.  
Casing height above land surface: 24 in. weight Sch. 40 PVC lbs./ft. Wall thickness or gauge No. --

TYPE OF SCREEN OR PERFORATION MATERIAL:  
1 Steel 3 Stainless steel 5 Fiberglass 7 PVC 10 Asbestos-cement  
2 Brass 4 Galvanized steel 6 Concrete tile 8 RMP (SR) 11 Other (specify) --  
12 None used (open hole)

SCREEN OR PERFORATION OPENINGS ARE:  
1 Continuous slot 3 Mill slot 5 Gauzed wrapped 8 Saw cut 11 None (open hole)  
2 Louvered shutter 4 Key punched 6 Wire wrapped 9 Drilled holes  
7 Torch cut 10 Other (specify) --

SCREEN-PERFORATED INTERVALS: From 19 ft. to 34 ft. From -- ft. to -- ft.  
From -- ft. to -- ft. From -- ft. to -- ft.  
GRAVEL PACK INTERVALS: From 18 ft. to 34 ft. From -- ft. to -- ft.  
From -- ft. to -- ft. From -- ft. to -- ft.

6 GROUT MATERIAL: 1 Neat cement 2 Cement grout 3 Bentonite 4 Other --  
Grout Intervals: From GL ft. to 16 ft. From 16 ft. to 18 ft. From -- ft. to -- ft.

What is the nearest source of possible contamination:  
1 Septic tank 4 Lateral lines 7 Pit privy 10 Livestock pens 14 Abandoned water well  
2 Sewer lines 5 Cess pool 8 Sewage lagoon 11 Fuel storage 15 Oil well/Gas well  
3 Watertight sewer lines 6 Seepage pit 9 Feedyard 12 Fertilizer storage 16 Other (specify below) contaminated site  
13 Insecticide storage

Direction from well? How many feet?

FROM	TO	LITHOLOGIC LOG	FROM	TO	PLUGGING INTERVALS
GL	3.5	Soil, Clay <sup>ly</sup> silt			
3.5	13.0	Clayey Silt			
13.0	23.0	silty clay			
23.0	25.5	clayey silt			
25.5	34.0	sand			
34.0	TD	End of Borehole			

Flush Mount waiver 11-28-94  
D. Taylor

7 CONTRACTOR'S OR LANDOWNER'S CERTIFICATION: This water well was (1) constructed, (2) reconstructed, or (3) plugged under my jurisdiction and was completed on (mo/day/year) 1-18-95 and this record is true to the best of my knowledge and belief. Kansas Water Well Contractor's License No. 585 This Water Well Record was completed on (mo/day/yr) 2-6-95 under the business name of Associated Environmental, Inc by (signature) Dee Johnson for Darin Duncan