


1 LOCATION OF WATER WELL: County: Shawnee 089 Fraction: SE 1/4 NE 1/4 NW 1/4 Section Number: 27 Township Number: T 11 S Range Number: R16 E/W

Distance and direction from nearest town or city street address of well if located within city?
Billard Airport, Topeka, Kansas

2 WATER WELL OWNER: RR#, St. Address, Box # : **Metropolitan Topeka Airport Authority** Board: **Arthur D. St. Dennis** Water Resources
 City, State, ZIP Code : **P.O. Box 19053, Topeka, Ks 66619** Application Number:

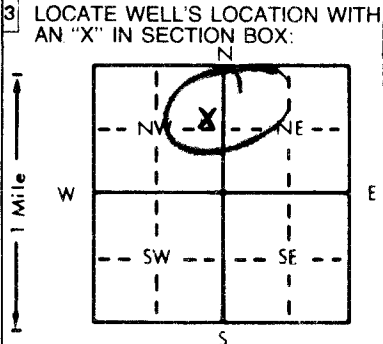

4 DEPTH OF COMPLETED WELL: 35 ft. ELEVATION: 878.97
 Depth(s) Groundwater Encountered 1. 26.5 ft. 2. — ft. 3. — ft.
 WELL'S STATIC WATER LEVEL 26.81 ft. below land surface measured on mo/day/yr 1-19-95
 Pump test data: Well water was — ft. after — hours pumping — gpm
 Est. Yield — gpm; Well water was — ft. after — hours pumping — gpm
 Bore Hole Diameter: 8.625 in. to 35 ft., and — in. to — ft.
 WELL WATER TO BE USED AS:
 5 Public water supply 8 Air conditioning 11 Injection well
 1 Domestic 3 Feedlot 6 Oil field water supply 9 Dewatering 12 Other (Specify below)
 2 Irrigation 4 Industrial 7 Lawn and garden only 10 Monitoring well MW-9
 Was a chemical/bacteriological sample submitted to Department? Yes — No X. If yes, mo/day/yr sample was submitted —
 Water Well Disinfected? Yes — No X

5 TYPE OF BLANK CASING USED:
 1 Steel 2 PVC 3 RMP (SR) 4 ABS 5 Wrought iron 6 Asbestos-Cement 7 Fiberglass 8 Concrete tile 9 Other (specify below)
 Blank casing diameter 2 in. to 19.5 ft., Dia — in. to — ft., Dia — in. to — ft.
 Casing height above land surface: 24 in., weight Sch. 40 PVC lbs./ft. Wall thickness or gauge No. —
 TYPE OF SCREEN OR PERFORATION MATERIAL:
 1 Steel 2 Brass 3 Stainless steel 4 Galvanized steel 5 Fiberglass 6 Concrete tile 7 PVC 8 RMP (SR) 9 ABS 10 Asbestos-cement 11 Other (specify) 12 None used (open hole)
 SCREEN OR PERFORATION OPENINGS ARE:
 1 Continuous slot 2 Louvered shutter 3 Mill slot 4 Key punched 5 Gauzed wrapped 6 Wire wrapped 7 Torch cut 8 Saw cut 9 Drilled holes 10 Other (specify) 11 None (open hole)
 SCREEN-PERFORATED INTERVALS: From 19.5 ft. to 34.5 ft., From — ft. to — ft., From — ft. to — ft.
 SAND GRAVEL PACK INTERVALS: From 18 ft. to 35 ft., From — ft. to — ft., From — ft. to — ft.

6 GROUT MATERIAL: 1 Neat cement 2 Cement grout 3 Bentonite 4 Other
 Grout Intervals: From 0 ft. to 16 ft., From 16 ft. to 18 ft., From — ft. to — ft.
 What is the nearest source of possible contamination:
 1 Septic tank 2 Sewer lines 3 Watertight sewer lines 4 Lateral lines 5 Cess pool 6 Seepage pit 7 Pit privy 8 Sewage lagoon 9 Feedyard 10 Livestock pens 11 Fuel storage 12 Fertilizer storage 13 Insecticide storage 14 Abandoned water well 15 Oil well/Gas well 16 Other (specify below)
contaminated site
 Direction from well? How many feet?

FROM	TO	LITHOLOGIC LOG	FROM	TO	PLUGGING INTERVALS
GL	2.5	Soil, Clayey Silt			
2.5	13.5	Clayey Silt			
13.5	26.5	Silty Clay			
26.5	35.0	Sand			
35.0	TD	End of Borehole			

Flush mount waiver
11-28-95
D. Taylor

7 CONTRACTOR'S OR LANDOWNER'S CERTIFICATION: This water well was (1) constructed, (2) reconstructed, or (3) plugged under my jurisdiction and was completed on (mo/day/year) 1-18-95 and this record is true to the best of my knowledge and belief. Kansas Water Well Contractor's License No. 585 This Water Well Record was completed on (mo/day/yr) 2-6-95 under the business name of Associated Environmental, Inc by (signature) Dee Johnson for Dawn Duncan

OFFICE USE ONLY
T
R
E/W
SEC