


1 LOCATION OF WATER WELL: Fraction NE 1/4 NE 1/4 SW 1/4 Section Number 31 Township Number T 11 S Range Number R 16 E

County: Shawnee
 Distance and direction from nearest town or city street address of well if located within city?
810 SW Topeka Ave, Topeka, KS.

2 WATER WELL OWNER: Kwik Shop
 RR#, St. Address, Box #: 734 E. 4th
 City, State, ZIP Code: Hutchinson, Ks. 67504
 Board of Agriculture, Division of Water Resources
 Application Number:

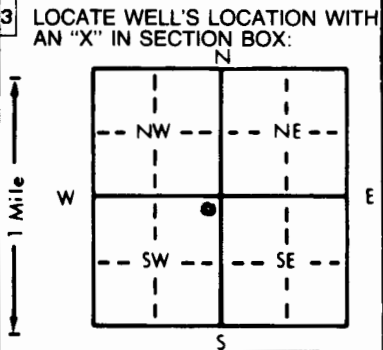

4 DEPTH OF COMPLETED WELL: 18'6" ft. ELEVATION: ft.
 Depth(s) Groundwater Encountered: 1'13" ft. 2. ft. 3. ft.
 WELL'S STATIC WATER LEVEL: 1'49" ft. below land surface measured on mo/day: 5-18-95
 Pump test data: Well water was ft. after hours pumping gpm
 Est. Yield gpm: Well water was ft. after hours pumping gpm
 Bore Hole Diameter: 8 1/2" in. to 14" ft., and 5 1/2" in. to 18 1/2" ft.
 WELL WATER TO BE USED AS:
 5 Public water supply 8 Air conditioning 11 Injection well
 1 Domestic 3 Feedlot 6 Oil field water supply 9 Dewatering 12 Other (Specify below)
 2 Irrigation 4 Industrial 7 Lawn and garden only 10 Monitoring well
 Was a chemical/bacteriological sample submitted to Department? Yes.....No.....X; If yes, mo/day/yr sample was submitted
 Water Well Disinfected? Yes.....(No)

5 TYPE OF BLANK CASING USED:
 1 Steel 3 RMP (SR) 5 Wrought iron 8 Concrete tile CASING JOINTS: Glued.....Clamped.....
 2 PVC 4 ABS 6 Asbestos-Cement 9 Other (specify below) Welded.....
 7 Fiberglass Threaded.....X
 Blank casing diameter: 2.375 in. to 8'3" ft., Dia.....in. to ft., Dia.....in. to SDR 13 ft.
 Casing height above land surface: Flush Mt. in., weight lbs./ft. Wall thickness or gauge No. SCH. 40
 TYPE OF SCREEN OR PERFORATION MATERIAL:
 1 Steel 3 Stainless steel 5 Fiberglass 8 RMP (SR) 10 Asbestos-cement 11 Other (specify).....
 2 Brass 4 Galvanized steel 6 Concrete tile 9 ABS 12 None used (open hole)
 SCREEN OR PERFORATION OPENINGS ARE:
 1 Continuous slot 3 Mill slot 5 Gauzed wrapped 8 Saw cut 11 None (open hole)
 2 Louvered shutter 4 Key punched 6 Wire wrapped 9 Drilled holes
 7 Torch cut 10 Other (specify).....
 SCREEN-PERFORATED INTERVALS: From 18'3" ft. to 8'3" ft., From ft. to ft.
 From ft. to ft., From ft. to ft.
 GRAVEL PACK INTERVALS: From 18'6" ft. to 6' ft., From ft. to ft.
 From ft. to ft., From ft. to ft.

6 GROUT MATERIAL:
 1 Neat cement 2 Cement grout 3 Bentonite 4 Other
 Grout Intervals: From 6'4" ft. to ft., From 4' ft. to 0' ft., From ft. to ft.
 What is the nearest source of possible contamination:
 1 Septic tank 4 Lateral lines 7 Pit privy 10 Livestock pens 14 Abandoned water well
 2 Sewer lines 5 Cess pool 8 Sewage lagoon 11 Fuel storage 15 Oil well/Gas well
 3 Watertight sewer lines 6 Seepage pit 9 Feedyard 12 Fertilizer storage 16 Other (specify below)
 13 Insecticide storage
 Direction from well? North How many feet? 80'

FROM	TO	LITHOLOGIC LOG	FROM	TO	PLUGGING INTERVALS
0	.75	Asphalt over ls.rx. gravel.			
.75	4	Dk brn silty mottled clay, organics, root frag., moist, earthy odor, iron oxides.			
4	11	Med brn silty clay w/ gray brn clay mottling & iron oxides staining clay fill, moist, no odor.			
11	14	Green yellow brn mottled silty sandy clay till, odor, slight to mod. fine-med. grained sand. Wet at 13'			
14	15	Limestone			
15	18'6"	Gray brn shale, dry.			

7 CONTRACTOR'S OR LANDOWNER'S CERTIFICATION: This water well was (1) constructed (2) reconstructed, or (3) plugged under my jurisdiction and was completed on (mo/day/year) 4-25-95 and this record is true to the best of my knowledge and belief. Kansas Water Well Contractor's License No. 539 This Water Well Record was completed on (mo/day/yr) 5-19-95 under the business name of JB Environmental Drilling by (signature) James Becker

OFFICE USE ONLY
T
R
EW
SEC
1/4
1/4
1/4