


MW-4

1 LOCATION OF WATER WELL: County: Shawnee Fraction: NE 1/4 NE 1/4 SW 1/4 Section Number: 31 Township Number: T 11 S Range Number: R 16 E  
 Distance and direction from nearest town or city street address of well if located within city?  
801 SW Topeka Ave., Topeka, KS.

2 WATER WELL OWNER: Kwik Shop  
 RR#, St. Address, Box #: 734 E. 4th Ave, Board of Agriculture, Division of Water Resources  
 City, State, ZIP Code: Hutchinson, KS. 67504-1927 Application Number:

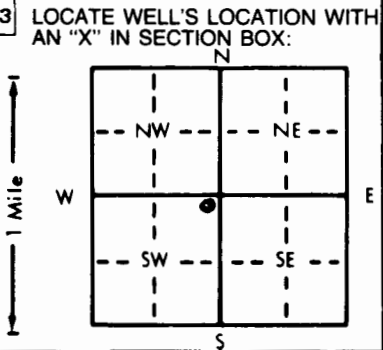

4 DEPTH OF COMPLETED WELL: 18' ft. ELEVATION: ..... ft.  
 Depth(s) Groundwater Encountered: 1. 8' ft. 2. .... ft. 3. .... ft.  
 WELL'S STATIC WATER LEVEL: 4.35 ft. below land surface measured on mo/day/yr 6-18-95  
 Pump test data: Well water was ..... ft. after ..... hours pumping ..... gpm  
 Est. Yield ..... gpm; Well water was ..... ft. after ..... hours pumping ..... gpm  
 Bore Hole Diameter: 8 1/2" - 10" to ..... ft., and ..... in. to ..... ft.  
 WELL WATER TO BE USED FOR:  
 1 Domestic 3 Feedlot 6 Oil field water supply 9 Dewatering 12 Other (Specify below)  
 2 Irrigation 4 Industrial 7 Lawn and garden only 10 Monitoring well  
 Was a chemical/bacteriological sample submitted to Department? Yes ..... No X ..... If yes, mo/day/yr sample was submitted  
 Water Well Disinfected? Yes ..... No X .....

5 TYPE OF BLANK CASING USED:  
 1 Steel 3 RMP (SR) 5 Wrought iron 8 Concrete tile CASING JOINTS: Glued ..... Clamped .....  
2 PVC 4 ABS 6 Asbestos-Cement 9 Other (specify below) Welded .....  
 7 Fiberglass Threaded ..... X .....  
 Blank casing diameter 2.375 in. to 7.10" ft., Dia ..... in. to ..... ft., Dia ..... in. to SDR 13 ft.  
 Casing height above land surface Flush Mt.  $\phi$  in., weight ..... lbs./ft. Wall thickness or gauge No. SCH 40  
 TYPE OF SCREEN OR PERFORATION MATERIAL:  
 1 Steel 3 Stainless steel 5 Fiberglass 7 PVC 10 Asbestos-cement  
 2 Brass 4 Galvanized steel 6 Concrete tile 8 RMP (SR) 11 Other (specify) .....  
 9 ABS 12 None used (open hole)  
 SCREEN OR PERFORATION OPENINGS ARE:  
 1 Continuous slot 3 Mill slot 5 Gauzed wrapped 8 Saw cut 11 None (open hole)  
 2 Louvered shutter 4 Key punched 6 Wire wrapped 9 Drilled holes  
 7 Torch cut 10 Other (specify) .....  
 SCREEN-PERFORATED INTERVALS: From 17'10" ft. to 7'10" ft., From ..... ft. to ..... ft.  
 From ..... ft. to ..... ft., From ..... ft. to ..... ft.  
 GRAVEL PACK INTERVALS: From 18' ft. to 6' ft., From ..... ft. to ..... ft.  
 From ..... ft. to ..... ft., From ..... ft. to ..... ft.

6 GROUT MATERIAL: 1 Neat cement 2 Cement grout 3 Bentonite 4 Other  
 Grout Intervals: From 6' ft. to 4' ft., From 4' ft. to 0' ft., From ..... ft. to ..... ft.  
 What is the nearest source of possible contamination:  
 1 Septic tank 4 Lateral lines 7 Pit privy 11 Fuel storage 14 Abandoned water well  
 2 Sewer lines 5 Cess pool 8 Sewage lagoon 12 Fertilizer storage 15 Oil well/Gas well  
 3 Watertight sewer lines 6 Seepage pit 9 Feedyard 13 Insecticide storage 16 Other (specify below)  
 Direction from well? South How many feet? 65'

FROM	TO	LITHOLOGIC LOG	FROM	TO	PLUGGING INTERVALS
0	5	Grass-dk brn silty clay, earthy odor, moist.			
5	10	Green-yellow mustard colored, weathered mottled shaley clay to shale, odor increasing w/ depth, moist, weathered ls.rx. layer at 8 1/2' and 9 1/2'.			
10	13	Weathered limestone.			
13	18	Gray shale, dry, no odor.			

7 CONTRACTOR'S OR LANDOWNER'S CERTIFICATION: This water well was (1) constructed, (2) reconstructed, or (3) plugged under my jurisdiction and was completed on (mo/day/year) 4-24-95 and this record is true to the best of my knowledge and belief. Kansas Water Well Contractor's License No. 539 This Water Well Record was completed on (mo/day/yr) 5-19-95 under the business name of JB Environmental Drilling by (signature) James Becker

OFFICE USE ONLY

T

R

EW

SEC

1/4

1/4

1/4