


1 LOCATION OF WATER WELL: Fraction **NE 1/4 SW 1/4** Section Number **31** Township Number **T 11 S** Range Number **R 16 EW**
 County: **Shawnee**

Distance and direction from nearest town or city street address of well if located within city?
810 SW Topeka Ave, Topeka, KS. Kwik Shop

2 WATER WELL OWNER: **734 E. 4th Hutchinson, Ks. 67504**
 RR#, St. Address, Box #: **Hutchinson, Ks. 67504**
 City, State, ZIP Code: **Hutchinson, Ks. 67504**
 Board of Agriculture, Division of Water Resources
 Application Number:

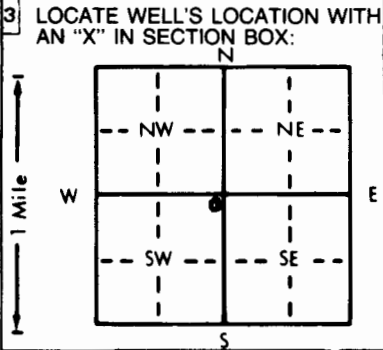

4 DEPTH OF COMPLETED WELL **18'** ft. ELEVATION: ft.
 Depth(s) Groundwater Encountered **1. 10'** ft. 2. ft. 3. ft.
 WELL'S STATIC WATER LEVEL **10.24** ft. below land surface measured on mo/day/yr **5-18-95**
 Pump test data: Well water was ft. after hours pumping gpm
 Est. Yield gpm; Well water was ft. after hours pumping gpm
 Bore Hole Diameter **8 1/2"** in. to **10"** ft., and in. to ft.
 WELL WATER TO BE USED AS **10** Public water supply 8 Air conditioning 11 Injection well
 1 Domestic 3 Feedlot 6 Oil field water supply 9 Dewatering 12 Other (Specify below)
 2 Irrigation 4 Industrial 7 Lawn and garden only **10** Monitoring well
 Was a chemical/bacteriological sample submitted to Department? Yes No **X**; If yes, mo/day/yr sample was submitted
 Water Well Disinfected? Yes No **X**

5 TYPE OF BLANK CASING USED:
 1 Steel 3 RMP (SR) 5 Wrought iron 8 Concrete tile CASING JOINTS: Glued Clamped
2 PVC 4 ABS 6 Asbestos-Cement 9 Other (specify below) Welded
 7 Fiberglass Threaded **X**
 Blank casing diameter **2.375** in. to ft., Dia in. to ft., Dia in. to SDR 13 ft.
 Casing height above land surface **FLUSH H2O** in., weight lbs./ft. Wall thickness or gauge No. **SCH 40**
 TYPE OF SCREEN OR PERFORATION MATERIAL:
7 PVC 10 Asbestos-cement
 1 Steel 3 Stainless steel 5 Fiberglass 8 RMP (SR) 11 Other (specify)
 2 Brass 4 Galvanized steel 6 Concrete tile 9 ABS 12 None used (open hole)
 SCREEN OR PERFORATION OPENINGS ARE:
 1 Continuous slot **3 Mill slot** 5 Gauzed wrapped 8 Saw cut 11 None (open hole)
 2 Louvered shutter 4 Key punched 6 Wire wrapped 9 Drilled holes
 7 Torch cut 10 Other (specify)
 SCREEN-PERFORATED INTERVALS: From **17'10"** ft. to **7'10"** ft., From ft. to ft.
 From ft. to ft., From ft. to ft.
 GRAVEL PACK INTERVALS: From **18'** ft. to **6'** ft., From ft. to ft.
 From ft. to ft., From ft. to ft.

6 GROUT MATERIAL: 1 Neat cement 2 Cement grout 3 Bentonite 4 Other
 Grout Intervals: From **6'** ft. to **4'** ft., From **4'** ft. to **0'** ft., From ft. to ft.
 What is the nearest source of possible contamination:
 1 Septic tank 4 Lateral lines 7 Pit privy 10 Livestock pens 14 Abandoned water well
 2 Sewer lines 5 Cess pool 8 Sewage lagoon 11 Fuel storage 15 Oil well/Gas well
 3 Watertight sewer lines 6 Seepage pit 9 Feedyard 12 Fertilizer storage 16 Other (specify below)
 13 Insecticide storage
 Direction from well? **North East** How many feet? **120'**

FROM	TO	LITHOLOGIC LOG	FROM	TO	PLUGGING INTERVALS
0	1	Asphalt/brick			
1	4.25	Dk gray stiff clay, mottled, no odor.			
4.25	7.25	Med brn silty clay, gravelly, no odor, ls.rx. gravel.			
7.25	10	Interbedded olive gray shales & thinly bedded ls.rx., no odor, dry.			
10	11	Limestone			
11	12	Gray shale, dry, no odor.			
12	14.75	Limestone, tan-gray, hard.			
14.75	18'	Gray shale, dry, no odor.			

7 CONTRACTOR'S OR LANDOWNER'S CERTIFICATION: This water well was **(1) constructed**, (2) reconstructed, or (3) plugged under my jurisdiction and was completed on (mo/day/year) **7-25-95** and this record is true to the best of my knowledge and belief. Kansas Water Well Contractor's License No. **539** This Water Well Record was completed on (mo/day/yr) **5-19-95** under the business name of **JB Environmental Drilling** by (signature) **James Becker**

OFFICE USE ONLY

T

R

EW

SEC

1/4

1/4

1/4