


1 LOCATION OF WATER WELL: Fraction NW 1/4 NE 1/4 NW 1/4 Section Number 33 Township Number T 11 S Range Number R 17 E

Distance and direction from nearest town or city street address of well if located within city?

7 Miles East of Topeka, KS

2 WATER WELL OWNER: Marie Kreipe
 RR#, St. Address, Box #: 7138 S.E. 2nd
 City, State, ZIP Code: Tecumseh, KS 66542
 Board of Agriculture, Division of Water Resources
 Application Number: #5372

3 LOCATE WELL'S LOCATION WITH AN "X" IN SECTION BOX: 4 DEPTH OF COMPLETED WELL: 60 ft. ELEVATION:

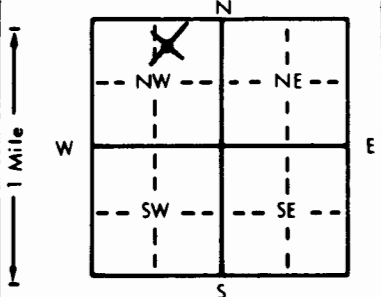

Depth(s) Groundwater Encountered 1. 18 ft. 2. ft. 3. ft.
 WELL'S STATIC WATER LEVEL . . . 18 . . . ft. below land surface measured on mo/day/yr . . . 7-15-95
 Pump test data: Well water was ft. after hours pumping gpm
 Est. Yield . . 1000 gpm: Well water was ft. after hours pumping gpm
 Bore Hole Diameter in. to ft., and in. to ft.
 WELL WATER TO BE USED AS: 5 Public water supply 8 Air conditioning 11 Injection well
 1 Domestic 3 Feedlot 6 Oil field water supply 9 Dewatering 12 Other (Specify below)
 2 Irrigation 4 Industrial 7 Lawn and garden only 10 Monitoring well
 Was a chemical/bacteriological sample submitted to Department? Yes No . . . X ; If yes, mo/day/yr sample was sub-
 mitted Water Well Disinfected? Yes X No

5 TYPE OF BLANK CASING USED: 5 Wrought iron 8 Concrete tile CASING JOINTS: Glued X Clamped
 1 Steel 3 RMP (SR) 6 Asbestos-Cement 9 Other (specify below) Welded
 2 PVC 4 ABS 7 Fiberglass Threaded

Blank casing diameter 1.6 . . . in. to . . . 40 . . . ft., Dia in. to ft., Dia in. to ft.
 Casing height above land surface 12 . . . in., weight 1.6 . 15 . . . lbs./ft. Wall thickness or gauge No. . . . 500

TYPE OF SCREEN OR PERFORATION MATERIAL: 7 PVC 10 Asbestos-cement
 1 Steel 3 Stainless steel 5 Fiberglass 8 RMP (SR) 11 Other (specify)
 2 Brass 4 Galvanized steel 6 Concrete tile 9 ABS 12 None used (open hole)

SCREEN OR PERFORATION OPENINGS ARE: 5 Gauzed wrapped 8 Saw cut 11 None (open hole)
 1 Continuous slot 3 Mill slot 6 Wire wrapped 9 Drilled holes
 2 Louvered shutter 4 Key punched 7 Torch cut 10 Other (specify)

SCREEN-PERFORATED INTERVALS: From . . . 40 . . . ft. to . . . 60 . . . ft., From ft. to ft.
 From ft. to ft., From ft. to ft.
 GRAVEL PACK INTERVALS: From . . . 20 . . . ft. to . . . 60 . . . ft., From ft. to ft.
 From ft. to ft., From ft. to ft.

6 GROUT MATERIAL: 1 Neat cement 2 Cement grout 3 Bentonite 4 Other
 Grout Intervals: From . . 0 ft. to . . . 20 ft., From ft. to ft., From ft. to ft.

What is the nearest source of possible contamination: None within 1/2 mile 10 Livestock pens 14 Abandoned water well
 1 Septic tank 4 Lateral lines 7 Pit privy 11 Fuel storage 15 Oil well/Gas well
 2 Sewer lines 5 Cess pool 8 Sewage lagoon 12 Fertilizer storage 16 Other (specify below)
 3 Watertight sewer lines 6 Seepage pit 9 Feedyard 13 Insecticide storage

Direction from well? How many feet?

FROM	TO	LITHOLOGIC LOG	FROM	TO	PLUGGING INTERVALS
0	5	Top; Soil			
5	22	Brown Silty Clay			
22	30	Medium Sand-Grey			
30	49	Course Sand & Gravel-Gray			
49	50	Brown Clay			
50	60	Course Sand & Gravel-Brown			

7 CONTRACTOR'S OR LANDOWNER'S CERTIFICATION: This water well was (1) constructed, (2) reconstructed, or (3) plugged under my jurisdiction and was completed on (mo/day/year) . . . 7-15-95 and this record is true to the best of my knowledge and belief. Kansas Water Well Contractor's License No. . . . 138 This Water Well Record was completed on (mo/day/yr) . . . 7-17-95 under the business name of Peterson Irrigation Inc. by (signature) Mike Peterson