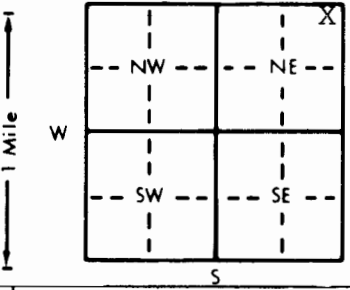


1 LOCATION OF WATER WELL:		Fraction	Section Number	Township Number	Range Number
County: JEFFERSON		NE 1/4 NE 1/4 NE 1/4	2	T 11 S	R 17 EW
Distance and direction from nearest town or city street address of well if located within city? 1 west, 3 1/2 north of Newman					
2 WATER WELL OWNER: Bob Clark					
RR#, St. Address, Box #: Rt. 1 469E					
City, State, ZIP Code: Ozawie, KS 66070					
Board of Agriculture, Division of Water Resources Application Number:					
3 LOCATE WELL'S LOCATION WITH AN "X" IN SECTION BOX:		4 DEPTH OF COMPLETED WELL: 288' ft. ELEVATION:			
		Depth(s) Groundwater Encountered 1. 238' ft. 2. ft. 3. ft.			
		WELL'S STATIC WATER LEVEL 172' ft. below land surface measured on mo/day/yr 3-4-96			
		Pump test data: Well water was ft. after hours pumping gpm			
		Est. Yield 7.0 GPH gpm Well water was ft. after hours pumping gpm			
		Bore Hole Diameter: 8 3/4 in. to ft. and in. to ft.			
		WELL WATER TO BE USED AS:			
		5 Public water supply 8 Air conditioning 11 Injection well			
		1 Domestic 3 Feedlot 6 Oil field water supply 9 Dewatering 12 Other (Specify below)			
		2 Irrigation 4 Industrial 7 Lawn and garden only 10 Monitoring well			
		Was a chemical/bacteriological sample submitted to Department? Yes No X; If yes, mo/day/yr sample was submitted			
		Water Well Disinfected? Yes X No			
5 TYPE OF BLANK CASING USED:					
1 Steel 3 RMP (SR) 5 Wrought iron 8 Concrete tile CASING JOINTS: Glued X Clamped					
2 PVC 4 ABS 6 Asbestos-Cement 9 Other (specify below) Welded					
7 Fiberglass Threaded					
Blank casing diameter 5" in. to 0-206 ft. Dia 5" in. to 286-288 ft. Dia in. to ft.					
Casing height above land surface 24" in. weight 2.82 lbs./ft. Wall thickness or gauge No. 258					
TYPE OF SCREEN OR PERFORATION MATERIAL:					
1 Steel 3 Stainless steel 5 Fiberglass 7 PVC 10 Asbestos-cement					
2 Brass 4 Galvanized steel 6 Concrete tile 8 RMP (SR) 11 Other (specify)					
9 ABS 12 None used (open hole)					
SCREEN OR PERFORATION OPENINGS ARE:					
1 Continuous slot 3 Mill slot 5 Gauzed wrapped 8 Saw cut 11 None (open hole)					
2 Louvered shutter 4 Key punched 6 Wire wrapped 9 Drilled holes					
7 Torch cut 10 Other (specify)					
SCREEN-PERFORATED INTERVALS: From 206 ft. to 286 ft. From ft. to ft.					
From ft. to ft. From ft. to ft.					
GRAVEL PACK INTERVALS: From 24 ft. to 288 ft. From ft. to ft.					
From ft. to ft. From ft. to ft.					
6 GROUT MATERIAL: 1 Neat cement 2 Cement grout 3 Bentonite 4 Other					
Grout Intervals: From 4 ft. to 24 ft. From ft. to ft. From ft. to ft.					
What is the nearest source of possible contamination:					
1 Septic tank 4 Lateral lines 7 Pit privy 10 Livestock pens 14 Abandoned water well					
2 Sewer lines 5 Cess pool 8 Sewage lagoon 11 Fuel storage 15 Oil well/Gas well					
3 Watertight sewer lines 6 Seepage pit 9 Feedyard 12 Fertilizer storage 16 Other (specify below)					
13 Insecticide storage					
Direction from well? north How many feet? 250'					
FROM	TO	LITHOLOGIC LOG	FROM	TO	PLUGGING INTERVALS
0	16	Clay-Brown	105	108	Limestone-Grey 274-290 Sh-Grey
16	25	Shale-Yellow	108	112	Shale-Grey
25	27	Limestone-Tan	112	118	Limestone-Grey
27	32	Shale-Grey	118	188	Shale-Grey
32	34	Shale-Grey	188	193	Limestone-Grey
34	39	Limestone-Grey	193	196	Shale-Grey
39	40	Shale-Grey	196	207	Limestone-Tan
40	47	Limestone-Tan	207	211	Shale-Grey
47	54	Shale-Grey	211	226	LS-Tan
54	57	Sandstone-Grey	226	230	Shale-Grey
57	68	Shale-Grey	230	239	SS-Grey 1 GPM
68	75	Sandstone-Grey	239	254	SANDY Shale-Grey
75	90	Shale-Grey	254	259	Limestone-Grey
90	102	Limestone-Grey	259	271	Shaley LS-Grey
102	105	Shale-Blk	271	274	LS-Grey
7 CONTRACTOR'S OR LANDOWNER'S CERTIFICATION: This water well was (1) constructed, (2) reconstructed, or (3) plugged under my jurisdiction and was completed on (mo/day/year) 3-04-96 and this record is true to the best of my knowledge and belief. Kansas					
Water Well Contractor's License No. 182 This Water Well Record was completed on (mo/day/yr) 3-13-96					
under the business name of STRADER DRILLING CO., INC. by (signature) Dale Strader					