


MW-9 2011081

1 LOCATION OF WATER WELL: Fraction SE 1/4 SE 1/4 SE 1/4 Section Number 13 Township Number T 11 S Range Number R 17 EAW

Distance and direction from nearest town or city street address of well if located within city? 1/4 mile N & 1/2 mile W of Grantville on N side of Hwy 24

2 WATER WELL OWNER: Brad Nelson RR#, St. Address, Box #: 1900 N Topeka City, State, ZIP Code: Topeka KS 66608 Board of Agriculture, Division of Water Resources Application Number:

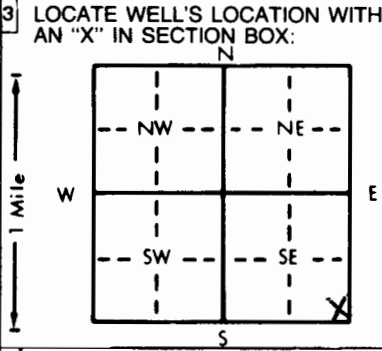

3 LOCATE WELL'S LOCATION WITH AN 'X' IN SECTION BOX: 4 DEPTH OF COMPLETED WELL: 40 ft. ELEVATION: 21.7 ft. WELL'S STATIC WATER LEVEL: 21.95 ft. below land surface measured on mo/day/yr 5-26-93

5 TYPE OF BLANK CASING USED: 1 Steel 2 PVC 3 RMP (SR) 4 ABS 5 Wrought iron 6 Asbestos-Cement 7 Fiberglass 8 Concrete tile 9 Other (specify below) 10 Asbestos-cement CASING JOINTS: Glued Clamped Welded Threaded Flush

Blank casing diameter: 2 in. Dia: 2 in. Casing height above land surface: Flush in. weight: 703 lbs./ft. Wall thickness or gauge No.: 154

TYPE OF SCREEN OR PERFORATION MATERIAL: 1 Steel 2 Brass 3 Stainless steel 4 Galvanized steel 5 Fiberglass 6 Concrete tile 7 PVC 8 RMP (SR) 9 ABS 10 Asbestos-cement 11 Other (specify) 12 None used (open hole)

SCREEN OR PERFORATION OPENINGS ARE: 1 Continuous slot 2 Louvered shutter 3 Mill slot 4 Key punched 5 Gauzed wrapped 6 Wire wrapped 7 Torch cut 8 Saw cut 9 Drilled holes 10 Other (specify) 11 None (open hole)

SCREEN-PERFORATED INTERVALS: From 15 ft. to 40 ft. GRAVEL PACK INTERVALS: From 14 ft. to 40 ft.

6 GROUT MATERIAL: 1 Neat cement 2 Cement grout 3 Bentonite 4 Other Grout Intervals: From 14 ft. to 1 ft.

Table with 2 columns: FROM TO LITHOLOGIC LOG FROM TO PLUGGING INTERVALS. Rows include soil types like 'Top soil', 'Clay, brown, silty', 'Silt, tan, clayey', 'Sand, tan, scattered gravel'.

Flush mount waiver granted on 3-18-93 for Quality Gas & Shop by Don Taylor

7 CONTRACTOR'S OR LANDOWNER'S CERTIFICATION: This water well was (1) constructed, (2) reconstructed, or (3) plugged under my jurisdiction and was completed on (mo/day/year) 5-26-93 and this record is true to the best of my knowledge and belief. Kansas Water Well Contractor's License No. 531 This Water Well Record was completed on (mo/day/yr) 6-14-93 under the business name of GSI by (signature) Allison Ivins