


1 LOCATION OF WATER WELL: Fraction ~~SW~~ 1/4 SW 1/4 SW 1/4 Section Number 18 Township Number T 11 S Range Number R 17 E

Distance and direction from nearest town or city street address of well if located within city? 1/4 m N and 3/8 m W of Grantville, N. of Hwy 24 approx. 400' Known as MW-5

2 WATER WELL OWNER: Jerry & Georgia Marie Brown  
 RR#, St. Address, Box #: 411 Central Methodist Square  
 City, State, ZIP Code: Fayette, MO 65248  
 Board of Agriculture, Division of Water Resources  
 Application Number: N/A

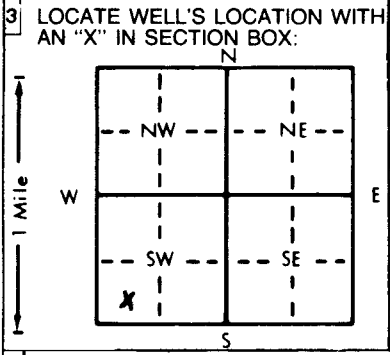

4 DEPTH OF COMPLETED WELL: 82 ft. ELEVATION:  
 Depth(s) Groundwater Encountered 1. 33 ft. 2. ft. 3. ft.  
 WELL'S STATIC WATER LEVEL ft. below land surface measured on mo/day/yr  
 Pump test data: Well water was ft. after hours pumping gpm  
 Est. Yield gpm: Well water was ft. after hours pumping gpm  
 Bore Hole Diameter: 7 5/8 in. to 82 ft., and in. to ft.  
 WELL WATER TO BE USED AS:  
 5 Public water supply 8 Air conditioning 11 Injection well  
 1 Domestic 3 Feedlot 6 Oil field water supply 9 Dewatering 12 Other (Specify below)  
 2 Irrigation 4 Industrial 7 Lawn and garden only 10 Monitoring well  
 Was a chemical/bacteriological sample submitted to Department? Yes.....No.....; If yes, mo/day/yr sample was submitted  
 Water Well Disinfected? Yes No

5 TYPE OF BLANK CASING USED:  
 1 Steel 3 RMP (SR) 5 Wrought iron 8 Concrete tile CASING JOINTS: Glued Clamped  
 2 PVC 4 ABS 6 Asbestos-Cement 9 Other (specify below) Welded  
 7 Fiberglass Threaded  
 Blank casing diameter 2 in. to 22 ft., Dia 2 in. to 37 to 7.7 ft., Dia in. to ft.  
 Casing height above land surface: 28 in., weight lbs./ft. Wall thickness or gauge No. Sch 40  
 TYPE OF SCREEN OR PERFORATION MATERIAL:  
 1 Steel 3 Stainless steel 5 Fiberglass 8 RMP (SR) 10 Asbestos-cement 11 Other (specify)  
 2 Brass 4 Galvanized steel 6 Concrete tile 9 ABS 12 None used (open hole)  
 SCREEN OR PERFORATION OPENINGS ARE:  
 1 Continuous slot 3 Mill slot 5 Gauzed wrapped 8 Saw cut 11 None (open hole)  
 2 Louvered shutter 4 Key punched 6 Wire wrapped 9 Drilled holes  
 7 Torch cut 10 Other (specify)  
 SCREEN-PERFORATED INTERVALS: From 22 ft. to 3.7 ft., From 7.7 ft. to 82 ft.  
 From ft. to ft., From ft. to ft.  
 GRAVEL PACK INTERVALS: From 21 ft. to 82 ft., From ft. to ft.  
 From ft. to ft., From ft. to ft.

6 GROUT MATERIAL: 1 Neat cement 2 Cement grout 3 Bentonite 4 Other  
 Grout Intervals: From 0 ft. to 19 ft., From 19 ft. to 21 ft., From ft. to ft.  
 What is the nearest source of possible contamination:  
 1 Septic tank 4 Lateral lines 7 Pit privy 10 Livestock pens 14 Abandoned water well  
 2 Sewer lines 5 Cess pool 8 Sewage lagoon 11 Fuel storage 15 Oil well/Gas well  
 3 Watertight sewer lines 6 Seepage pit 9 Feedyard 12 Fertilizer storage 16 Other (specify below)  
 13 Insecticide storage  
 Direction from well? How many feet? ~ 320 ft

FROM	TO	LITHOLOGIC LOG	FROM	TO	PLUGGING INTERVALS
0	8	Black and brown soil, lean			
8	12	lt brown to gray silt			
12	18	silty clay to clay, gray, moist			
18	23	gray clay, plastic, wet			
23	28	sandy clay to fine sand			
28	33	fine to medium sand			
33	39	medium sand to medium gravel			
39	45	medium sand to fine gravel			
45	58	poorly sorted sand & gravel			
58	65	fine to med gravel			
65	73	sand and gravel, med to coarse			
73	82	sand and gravel, med			
82		glacial boulders and till - Auger refusal			

7 CONTRACTOR'S OR LANDOWNER'S CERTIFICATION: This water well was (1) constructed, (2) reconstructed, or (3) plugged under my jurisdiction and was completed on (mo/day/year) 10-18-91 and this record is true to the best of my knowledge and belief. Kansas Water Well Contractor's License No. KDHE - BLR This Water Well Record was completed on (mo/day/yr) 10-22-91 under the business name of by (signature) Daniel Kellerman