


1 LOCATION OF WATER WELL: Fraction S.E. 1/4 S.E. 1/4 N.W. 1/4 Section Number 20 Township Number T 11 S Range Number R 17 **(E/W)**
 County: Jefferson

Distance and direction from nearest town or city street address of well if located within city? 3/4 mile E. & 100ft. N. of S.E. corner of Grantville, Ks.

2 WATER WELL OWNER: Dennis Spreer
 RR#, St. Address, Box #: Rt. 1 Bx. 24 Board of Agriculture, Division of Water Resources
 City, State, ZIP Code: Grantville, Ks. 66429 Application Number:

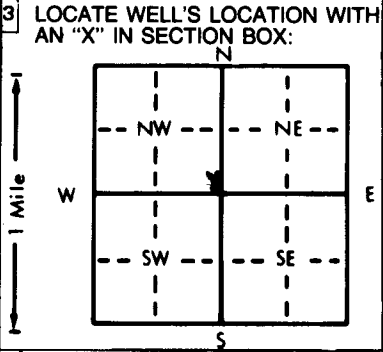

4 DEPTH OF COMPLETED WELL 51 ft. ELEVATION:
 Depth(s) Groundwater Encountered 1. 26 ft. 2. _____ ft. 3. _____ ft.
 WELL'S STATIC WATER LEVEL _____ ft. below land surface measured on mo/day/yr 9-28-89
 Pump test data: Well water was 29 ft. after 1 hours pumping 25 gpm
 Est. Yield 100 gpm: Well water was 33 ft. after 2 hours pumping 25 gpm
 Bore Hole Diameter 24 in. to 51 ft., and _____ in. to _____ ft.
 WELL WATER TO BE USED AS:
 5 Public water supply 8 Air conditioning 11 Injection well
 1 Domestic 3 Feedlot 6 Oil field water supply 9 Dewatering 12 Other (Specify below)
 2 Irrigation 4 Industrial 7 Lawn and garden only 10 Observation well
 Was a chemical/bacteriological sample submitted to Department? Yes _____ No x; If yes, mo/day/yr sample was submitted _____
 Water Well Disinfected? Yes x No _____

5 TYPE OF BLANK CASING USED:
 1 Steel 3 RMP (SR) 5 Wrought iron 8 Concrete tile CASING JOINTS: Glued x Clamped _____
2 PVC 4 ABS 6 Asbestos-Cement 9 Other (specify below) Welded _____
 7 Fiberglass Threaded _____
 Blank casing diameter 8 in. to 41 ft., Dia _____ in. to _____ ft., Dia _____ in. to _____ ft.
 Casing height above land surface 24 in., weight _____ lbs./ft. Wall thickness or gauge No. 65
 TYPE OF SCREEN OR PERFORATION MATERIAL:
 1 Steel 3 Stainless steel 5 Fiberglass 7 PVC 10 Asbestos-cement
 2 Brass 4 Galvanized steel 6 Concrete tile 8 RMP (SR) 11 Other (specify) _____
 9 ABS 12 None used (open hole)
 SCREEN OR PERFORATION OPENINGS ARE:
 1 Continuous slot 3 Mill slot 5 Gauzed wrapped 8 Saw cut 11 None (open hole)
 2 Louvered shutter 4 Key punched 6 Wire wrapped 9 Drilled holes
 7 Torch cut 10 Other (specify) _____
 SCREEN-PERFORATED INTERVALS: From 41 ft. to 51 ft., From _____ ft. to _____ ft.
 From 20 ft. to _____ ft., From _____ ft. to _____ ft.
 GRAVEL PACK INTERVALS: From _____ ft. to 51 ft., From _____ ft. to _____ ft.
 From _____ ft. to _____ ft., From _____ ft. to _____ ft.

6 GROUT MATERIAL: 1 Neat cement 2 Cement grout 3 Bentonite 4 Other _____
 Grout Intervals: From 3 ft. to 20 ft., From _____ ft. to _____ ft., From _____ ft. to _____ ft.
 What is the nearest source of possible contamination:
 1 Septic tank 4 Lateral lines 7 Pit privy 10 Livestock pens 14 Abandoned water well
 2 Sewer lines 5 Cess pool 8 Sewage lagoon 11 Fuel storage 15 Oil well/Gas well
 3 Watertight sewer lines 6 Seepage pit 9 Feedyard 12 Fertilizer storage 16 Other (specify below)
 13 Insecticide storage
 Direction from well? S.E. How many feet? 100ft

FROM	TO	LITHOLOGIC LOG	FROM	TO	LITHOLOGIC LOG
0	1	Black soil			
1	12	Hard brown silt			
12	14	Fine brown sand			
14	26	Small-medium brown gravel & grey clay			
26	28	Small-medium brown gravel			
28	29	Small brown gravel			
29	31	Medium brown gravel & grey clay			
31	37	Large brown gravel			
37	39	Large brown gravel & grey clay			
39	42	Small brown gravel & grey clay			
42	44	Medium brown gravel			
44	51	Medium-large brown gravel			
	51	Stopped			

7 CONTRACTOR'S OR LANDOWNER'S CERTIFICATION: This water well was (1) constructed, (2) reconstructed, or (3) plugged under my jurisdiction and was completed on (mo/day/year) 9-28-89 and this record is true to the best of my knowledge and belief. Kansas Water Well Contractor's License No. 323 This Water Well Record was completed on (mo/day/yr) 7-7-89 under the business name of Hoobler Drilling Co. by (signature) Daniel Hoobler

INSTRUCTIONS: Use typewriter or ball point pen. PLEASE PRESS FIRMLY and PRINT clearly. Please fill in blanks, underline or circle the correct answers. Send top three copies to Kansas Department of Health and Environment, Office of Oil Field and Environmental Geology, Regulation and Permitting Section, Topeka, Kansas 66620-7500, Telephone: 913-862-9360. Send one to WATER WELL OWNER and retain one for your records.

OFFICE USE ONLY
T
R
EW
SEC
1/4
1/4
1/4