

WATER WELL RECORD Form WWC-5 KSA 82a-1212


1 LOCATION OF WATER WELL:	Fraction <u>NE</u> <u>SW</u> ¼ <u>SW</u> ¼	Section Number <u>23</u>	Township Number T <u>11</u> S	Range Number R <u>17</u> EW
----------------------------------	---	-----------------------------	----------------------------------	--------------------------------

Distance and direction from nearest town or city street address of well if located within city?

2 WATER WELL OWNER: Jim Lindley
 RR#, St. Address, Box # : Rt. 1 Box 64
 City, State, ZIP Code : Grantville, KS 66429

Board of Agriculture, Division of Water Resources
 Application Number: 40729

3 LOCATE WELL'S LOCATION WITH AN "X" IN SECTION BOX:

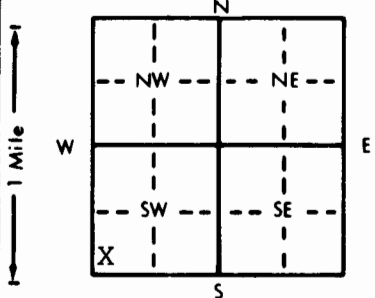

4 DEPTH OF COMPLETED WELL: 57'-6" ft. ELEVATION:

Depth(s) Groundwater Encountered 1. ft. 2. ft. 3. ft.

WELL'S STATIC WATER LEVEL 16'-7" ft. below land surface measured on mo/day/yr 11-23-93

Pump test data: Well water was ft. after hours pumping gpm

Est. Yield 1100 gpm: Well water was ft. after hours pumping gpm

Bore Hole Diameter 24" in. to ft., and in. to ft.

WELL WATER TO BE USED AS:

5 Public water supply	8 Air conditioning	11 Injection well
1 Domestic	3 Feedlot	6 Oil field water supply
2 Irrigation	4 Industrial	7 Lawn and garden only
		10 Monitoring well

Was a chemical/bacteriological sample submitted to Department? Yes No X If yes, mo/day/yr sample was submitted

Water Well Disinfected? Yes X No

5 TYPE OF BLANK CASING USED:

1 Steel	3 RMP (SR)	5 Wrought iron	8 Concrete tile	CASING JOINTS: Glued Clamped
2 PVC	4 ABS	6 Asbestos-Cement	9 Other (specify below)	Welded
		7 Fiberglass		Threaded

Blank casing diameter 16" in. to 0-44 ft., Dia 16" in. to 54-57 ft., Dia in. to ft.

Casing height above land surface 2'-6" in., weight 42 lbs lbs./ft. Wall thickness or gauge No. 250

TYPE OF SCREEN OR PERFORMANCE MATERIAL: Johnson 100 slot

1 Steel	3 Stainless steel	5 Fiberglass	8 RMP (SR)	10 Asbestos-cement
2 Brass	4 Galvanized steel	6 Concrete tile	9 ABS	11 Other (specify)
				12 None used (open hole)

SCREEN OR PERFORATION OPENINGS ARE:

<input checked="" type="checkbox"/> 1 Continuous slot	3 Mill slot	5 Gauzed wrapped	8 Saw cut	11 None (open hole)
2 Louvered shutter	4 Key punched	6 Wire wrapped	9 Drilled holes	
		7 Torch cut	10 Other (specify) <u>JOHNSON X100 slot</u>	

SCREEN-PERFORATED INTERVALS: From 44 ft. to 54 ft., From ft. to ft.

GRAVEL PACK INTERVALS: From 22 ft. to 57'-6" ft., From ft. to ft.

6 GROUT MATERIAL: 1 Neat cement 2 Cement grout 3 Bentonite 4 Other

Grout intervals: From 20 ft. to 22 ft., From 0 ft. to 20 ft., From ft. to ft.

What is the nearest source of possible contamination:

1 Septic tank	4 Lateral lines	7 Pit privy	10 Livestock pens	14 Abandoned water well
2 Sewer lines	5 Cess pool	8 Sewage lagoon	11 Fuel storage	15 Oil well/Gas well
3 Watertight sewer lines	6 Seepage pit	9 Feedyard	12 Fertilizer storage	16 Other (specify below)
			13 Insecticide storage	

Direction from well? How many feet?

FROM	TO	LITHOLOGIC LOG	FROM	TO	PLUGGING INTERVALS
0	6	Top Soil			
6	30	Clay-Brown-Silty			
30	32	Fine Sand-Brown			
32	35	Fine Sand-Coarse Sand-Med-Gravel, Brown			
35	50	" " " " Pea "			
50	54	" " " " Pea 1/2x1/2-Brown			
54	60	Shale-Grey			

7 CONTRACTOR'S OR LANDOWNER'S CERTIFICATION: This water well was (1) constructed, (2) reconstructed, or (3) plugged under my jurisdiction and was completed on (mo/day/year) 11-23-93 and this record is true to the best of my knowledge and belief. Kansas Water Well Contractor's License No. 182. This Water Well Record was completed on (mo/day/yr) 1-13-94 under the business name of STRADER DRILLING CO., INC. by (signature) *David Strader*

INSTRUCTIONS: Use typewriter or ball point pen. PLEASE PRESS FIRMLY and PRINT clearly. Please fill in blanks, underline or circle the correct answers. Send top three copies to Kansas Department of Health and Environment, Bureau of Water, Topeka, Kansas 66620-0001. Telephone: 913-296-5545. Send one to WATER WELL OWNER and retain one for your records.

OFFICE USE ONLY