


1	LOCATION OF WATER WELL:	Fraction	Section Number	Township Number	Range Number
	County: <u>SHAWNEE</u>	<u>NE 1/4 NE 1/4 NE 1/4</u>	<u>31</u>	<u>11</u>	<u>17</u>

Distance and direction from nearest town or city street address of well if located within city?
ABOUT 3000 FT. EAST OF SE DUPONT RD. + 500 FT. NORTH OF SE 2ND ST.

2 WATER WELL OWNER: VCB CELLO INC.
 RR #, St. Address, Box #: 6000 SE 2ND ST.
 City, State, ZIP Code : TECUMSEH, KS. 66542
 Board of Agriculture, Division of Water Resources
 Application Number:

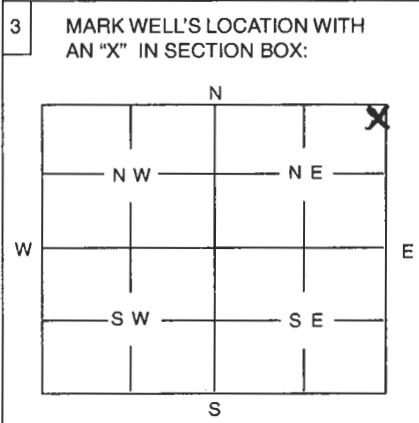

4 DEPTH OF WELL 17 ft
 WELL'S STATIC WATER LEVEL 6.8 ft
 WELL WAS USED AS:
 1 Domestic 5 Public Water Supply 9 Dewatering
 2 Irrigation 6 Oil Field Water Supply 10 ~~Monitoring Well~~
 3 Feedlot 7 Domestic (Lawn & Garden) 11 Injection Well
 4 Industrial 8 Air Conditioning 12 Other

Was a chemical / bacteriological sample submitted to Department? Yes No X
 If yes, mo/day/yr sample was submitted

Water Well Disinfected: Yes No X

5 TYPE OF BLANK CASING USED:
 1 Steel 3 RMP (SR) 5 Wrought 7 Fiberglass 9 Other (Specify below)
 2 PVC 4 ABS 6 Asbestos-Cement 8 Concrete Tile STAINLESS STEEL

Blank casing diameter 2 in Was casing pulled? Yes No X If yes, how much

Casing height above or below land surface 6 in.

6 GROUT PLUG MATERIAL: 1 Neat cement 2 Cement grout 3 Bentonite 4 Other BENTONITE CHIPS
 Grout Plug Intervals: From 17 ft. to .5 ft., From ft. to ft., From ft. to ft.

What is the nearest source of possible contamination:
 1 Septic tank 6 Seepage pit 11 Fuel storage 16 Other (specify below)
 2 Sewer lines 7 Pit privy 12 Fertilizer storage LANDFILL
 3 Watertight sewer lines 8 Sewage lagoon 13 Insecticide storage
 4 Lateral lines 9 Feedyard 14 Abandoned water well
 5 Cess Pool 10 Livestock pens 15 Oil well/Gas well

Direction from well? NE CORNER How many feet? PART OF IT
(INSIDE)

FROM	TO	PLUGGING MATERIALS
<u>17</u>	<u>.5</u>	<u>BENTONITE CHIPS</u>

RECEIVED
 OCT 05 2004
 BUREAU OF WATER

7 CONTRACTOR'S OR LANDOWNER'S CERTIFICATION: This water well was plugged under my jurisdiction and was completed on (mo/day/year) 7-25-04 and this record is true to the best of my knowledge and belief. Kansas Water Well Contractor's License No. 702 This Water Well Record was completed on (mo/day/year) 9-25-04 under the business name of BOWSER-MORNER INC by (signature) Janet L. Bochner

INSTRUCTIONS: Use typewriter or ball point pen. Please press firmly and print clearly. Please fill in blanks, underline or circle the correct answers. Send top three copies to Kansas Department of Health and Environment, Bureau of Water, Topeka, Kansas 66620-0001. Telephone: 785/296-3565. Send one to Water Well Owner and retain one for your records.