USE TYPEWRITER OR BALL POINT PEN-PRESS FIRMLY, PRINT CLEARLY.

?

WATER WELL RECORD
KSA 82a-1201-1215

not here

Kansas Department of Health and Environment-Division of Environment
(Water well Contractors)
Topeka, Kansas 66620

1. Location of well:	County	Fraction	Section number	Township number	Range number
	JEFFERSON	SW 1/4 SW 1/4 NE 1/4	19	T 11 S	R 17 E

2. Distance and direction from nearest town or city: COMUNITY CENTER

Street address of well location if in city: SOUTH SIDE GRANTVILLE

3. Owner of well: R. BIGHAM

R.R. or street:

City, state, zip code: GRANTVILLE

4. Locate with "X" in section below:

Sketch map:

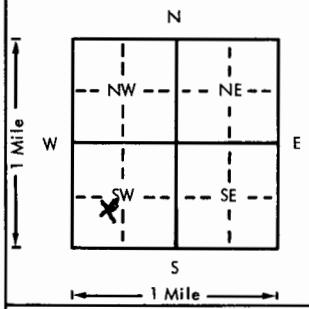

6. Bore hole dia. 5 in. Completion date 1-3-77
Well depth 41 ft.

7. ✓ Cable tool __ Rotary __ Driven __ Dug
__ Hollow rod __ Jetted __ Bored __ Reverse rotary

8. Use: __ Domestic ✓ Public supply __ Industry
__ Irrigation __ Air conditioning __ Stock
__ Lawn __ Oil field water __ Other

9. Casing: Material PLS Height: Above or below
Threaded ___ Welded ___ Surface 12" in.
RMP ✓ PVC ___ Weight ___ lbs./ft.
Dia. 8 in. to 30 ft. depth Wall Thickness: inches or
Dia. ___ in. to ___ ft. depth gage No. 200

10. Screen: Manufacturer's name SUNFLOWER 5" PLASTIC SLOTS 5'
Type ___ Dia. ___
Slot/gauze ___ Length ___
Set between ___ ft. and ___ ft.
___ ft. and ___ ft.
Gravel pack? ___ Size range of material ___

11. Static water level: mo./day/yr.
29 ft. below land surface Date 12-10-76

12. Pumping level below land surfaces:
32 ft. after 1 hrs. pumping 16 g.p.m.
30 ft. after 1 hrs. pumping 10 g.p.m.
Estimated maximum yield 18 g.p.m.

13. Water sample submitted: mo./day/yr.
___ Yes ✓ No Date ___

14. Well head completion:
___ Pitless adapter ___ Inches above grade

15. Well grouted? ✓
With: ✓ Neat cement ___ Bentonite ___ Concrete
Depth: From 5 ft. to 22 ft.

16. Nearest source of possible contamination:
ft. 60 Direction S-W Type S. TANK
Well disinfected upon completion? ✓ Yes ___ No

17. Pump: ___ Not installed
Manufacturer's name ___
Model number ___ HP ___ Volts ___
Length of drop pipe ___ ft. capacity ___ g.p.m.
Type:
___ Submersible ___ Turbine
___ Jet ___ Reciprocating
___ Centrifugal ___ Other

5. Type and color of material	From	To
TOP SOIL	0	7
SILT SOIL	7	13
HARD PAN	13	16
FINE SAND	16	20
SAND + CLAY	20	29
FINE SAND + GAVEL	29	41
FINE SAND	41	51
(Use a second sheet if needed)		

18. Elevation:

Topography:
✓ FLAT
___ Slope
___ Upland
___ Valley

19. Remarks: This well drilled under direction of Mr. Bigham completion by him. at his convenience or persons unknown To me H.L. Pettit

20. Water well contractor's certification:
This well was drilled under my jurisdiction and this report is true to the best of my knowledge and belief.
H.L. Pettit 333
Business name License No.
Address 605 N. Michigan
Signed H.L. Pettit Date 1-4-77
Authorized representative

T R W Sec 1/4 1/4 1/4 1/4

Forward the white, blue and pink copies to the Department of Health and Environment

Form WWC-5