

USE TYPEWRITER OR BALL POINT PEN-PRESS FIRMLY, PRINT CLEARLY.

WATER WELL RECORD
KSA 82a-1201-1215

Kansas Department of Health and Environment-Division of Environment (Water well Contractors) Topeka, Kansas 66620



bad
28

SE

<input checked="" type="checkbox"/> Location of well:	County Jefferson	Fraction SW NE NW Ctr. of S SW 1/4	Section number K.H.B.L. Survey 12	Township number T 11S	Range number S R 17E	E/W
Distance and direction from nearest town or city: Grantville, Ks. & 1/4 mi. East of		3. Owner of well: Bob Shirley & Don Barry		R.R. or street:		
Street address of well location if in city:		City, state, zip code: Grantville, Kansas 66429				

4. Locate with "X" in section below:

Sketch map: **U.S. 24**

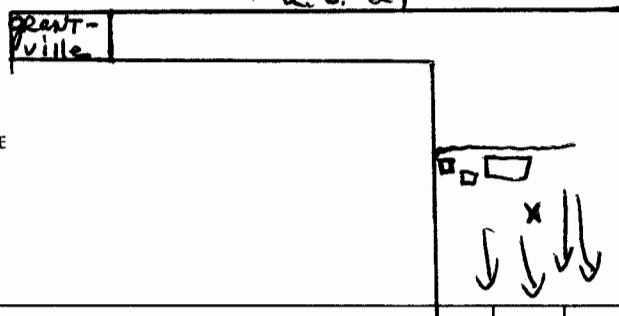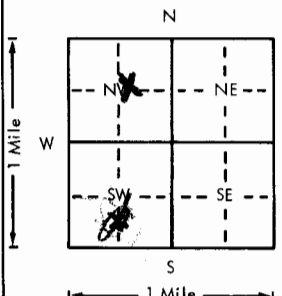

5. Type and color of material	From	To
Med. black soil	0	1
Fine brown silty sand	1	10
Small to med. brown gravel	10	13
Soft gray clay and small gravel	13	15
Med. brown gravel	15	24
Small gray gravel	24	26
Med. to large gray gravel & gray clay	26	30
Med. gray gravel	30	34
Med. to large gray gravel	34	60
Yellow till-stopped.	60	

6. Bore hole dia. **30** in. Completion date **3-19-77**
Well depth **60** ft.

7. Cable tool Rotary Driven Dug
 Hollow rod Jetted Bored Reverse rotary

8. Use: Domestic Public supply Industry
 Irrigation Air conditioning Stock
 Lawn Oil field water Other

9. Casing: Material **Trans** Height: (Above or below)
Threaded Welded Surface **12** in.
RMP PVC Weight _____ lbs./ft.
Dia. **16** in. to **34** ft. depth Wall Thickness: inches or
Dia. _____ in. to _____ ft. depth Gauge No. **.75"**

10. Screen: Manufacturer's name
Johnson Well Co.
Type **Transite** Dia. **16"**
(Slot) gauze **1/8 x 8** Length **26'**
Set between **34** ft. and **60** ft.
ft. and _____ ft.
Gravel pack? **yes** Size range of material **1/8-1/4"**

11. Static water level: _____ mo./day/yr.
19 ft. below land surface Date **3-21-77**

12. Pumping level below land surfaces:
27 ft. after **1** hrs. pumping **800** g.p.m.
35 ft. after **3** hrs. pumping **1000** g.p.m.
Estimated maximum yield **1300** g.p.m.

13. Water sample submitted: _____ mo./day/yr.
 Yes No Date _____

14. Well head completion:
 Pitless adapter _____ Inches above grade

15. Well grouted? **yes**
With: Neat cement Bentonite Concrete
Depth: From **0** ft. to **10** ft.

16. Nearest source of possible contamination:
ft. **1700** Direction **NW** Type **Farm**
Well disinfected upon completion? Yes No

17. Pump: Not installed
Manufacturer's name _____ HP _____ Volts _____
Model number _____ Length of drop pipe _____ ft. capacity _____ g.p.m.
Type:
 Submersible Turbine
 Jet Reciprocating
 Centrifugal Other

(Use a second sheet if needed)

18. Elevation: **865**
Topography:
 Hill
 Slope
 Upland
 Valley

19. Remarks: **We do not install pumps.**

20. Water well contractor's certification:
This well was drilled under my jurisdiction and this report is true to the best of my knowledge and belief.
Hoobler Drilling Co. **323**
Business name License No.
Address **St. Marys, Ks. 66536**
Signed **Don Hoobler** Date **4-6-77**
Authorized representative

11
120
28
CSW
1/4
1/4
1/4

BR < 805
7-04X3

DA