


1	LOCATION OF WATER WELL:	Fraction	Section Number	Township Number	Range Number
County:	Jefferson	SE $\frac{1}{4}$ SW $\frac{1}{4}$ SW $\frac{1}{4}$	18	11S	17E EW

Distance and direction from nearest town or city street address of well if located within city?
 Highway 24, Grantville, Ks

2	WATER WELL OWNER:	Brummit Oil Co., Inc. (Presto Pantry) P.O. Box 705
RR #, St. Address, Box #:	Leavenworth, KS 66048	Board of Agriculture, Division of Water Resources
City, State, ZIP Code		Application Number:

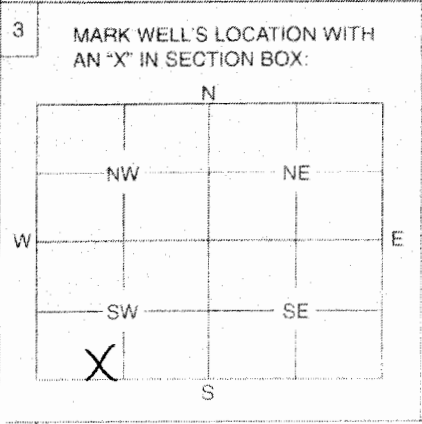

4	DEPTH OF WELL	39.3	ft.
	WELL'S STATIC WATER LEVEL	26.3	ft.
WELL WAS USED AS:			
1 Domestic	5 Public Water Supply	9 Dewatering	
2 Irrigation	6 Oil Field Water Supply	10 Monitoring Well	
3 Feedlot	7 Domestic (Lawn & Garden)	11 Injection Well	
4 Industrial	8 Air Conditioning	12 Other	
Was a chemical / bacteriological sample submitted to Department? Yes No <input checked="" type="checkbox"/>			
If yes, mo/day/yr sample was submitted			
Water Well Disinfected: Yes No <input checked="" type="checkbox"/>			

5 TYPE OF BLANK CASING USED:

1 Steel	3 RMP (SR)	5 Wrought	7 Fiberglass	9 Other (Specify below)
<input checked="" type="radio"/> 2 PVC	4 ABS	6 Asbestos-Cement	8 Concrete Tile	

Blank casing diameter 2 in. Was casing pulled? Yes No If yes, how much 3'

Casing height above or below land surface in.

6 GROUT PLUG MATERIAL:

1 Neat cement	2 Cement grout	<input checked="" type="radio"/> 3 Bentonite	<input checked="" type="radio"/> 4 Other <u>soil/asphalt</u>
---------------	----------------	--	--

Grout Plug Intervals: From 3 39.3 ft. to 3 ft. From 4 3 ft. to 0 ft. From to ft.

What is the nearest source of possible contamination:

1 Septic tank	6 Seepage pit	11 Fuel storage	<input checked="" type="radio"/> 15 Other (specify below) <u>contaminated site</u>
2 Sewer lines	7 Pit privy	12 Fertilizer storage	
3 Watertight sewer lines	8 Sewage lagoon	13 Insecticide storage	
4 Lateral lines	9 Feedyard	14 Abandoned water well	
5 Cess pool	10 Livestock pens	15 Oil well-Gas well	

Direction from well? How many feet?

FROM	TO	PLUGGING MATERIALS
39.3	3	Bentonite
3	0	Soil/ASphalt

7 CONTRACTOR'S OF LANDOWNER'S CERTIFICATION: This water well was plugged under my jurisdiction and was completed on (mo/day/year) 07/29/08 and this record is true to the best of my knowledge and belief. Kansas Water Well Contractor's License No. 585 This Water Well Record was completed on (mo/day/year) 08/29/08 under the business name of Associated Environmental, Inc. by (signature) *Barbara Johnson*

INSTRUCTIONS: Use typewriter or ball point pen. Please press firmly and print clearly. Please fill in blanks, underline or circle the correct answers. Send top three copies to Kansas Department of Health and Environment, Bureau of Water, Geology Section, 1000 SW Jackson St., Ste. 420, Topeka, Kansas 66612-1367. Telephone: 785/296-5522. Send one to Water Well Owner and retain one for your records.