


1	LOCATION OF WATER WELL: County: Jefferson	Fraction SE $\frac{1}{4}$ SW $\frac{1}{4}$ SW $\frac{1}{4}$	Section Number 18	Township Number 11S	Range Number 17E	E/W
---	---	--	-----------------------------	-------------------------------	----------------------------	-----

Distance and direction from nearest town or city street address of well if located within city?

Highway 24, Grantville, Ks

2	WATER WELL OWNER: RR #, St. Address, Box #: City, State, ZIP Code	Brummit Oil Co., Inc. (Presto Pantry) P.O. Box 705 Leavenworth, KS 66048	Board of Agriculture, Division of Water Resources Application Number:
---	---	---	--

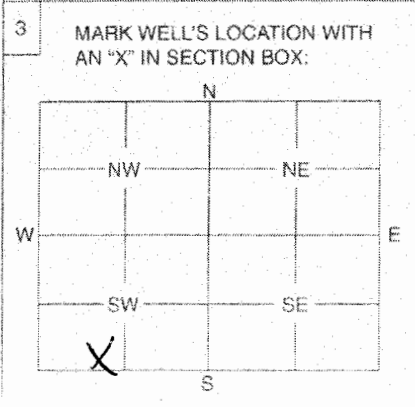

4	DEPTH OF WELL 17.2 ft. WELL'S STATIC WATER LEVEL Dry ft. WELL WAS USED AS: 1 Domestic 2 Irrigation 3 Feedlot 4 Industrial 5 Public Water Supply 6 Oil Field Water Supply 7 Domestic (Lawn & Garden) 8 Air Conditioning 9 Dewatering 10 Monitoring Well 11 Injection Well 12 Other
---	--

Was a chemical / bacteriological sample submitted to Department? Yes No **X**
If yes, mo/day/yr sample was submitted: _____
Water Well Disinfected: Yes No **X**

5	TYPE OF BLANK CASING USED: 1 Steel 2 PVC 3 RMP (SR) 4 ABS 5 Wrought 6 Asbestos-Cement 7 Fiberglass 8 Concrete Tile 9 Other (Specify below)
---	--

Blank casing diameter **2** in. Was casing pulled? Yes **X** No _____ If yes, how much **3'**
Casing height above or below land surface _____ in.

6	GROUT PLUG MATERIAL: 1 Neat cement 2 Cement grout 3 Bentonite 4 Other Soil/asphalt 5 Grout Plug Intervals: From 17.2 ft. to 3 ft. to 0 ft.
---	--

What is the nearest source of possible contamination:
1 Septic tank
2 Sewer lines
3 Watertight sewer lines
4 Lateral lines
5 Cess pool
6 Seepage pit
7 Pit privy
8 Sewage lagoon
9 Feedyard
10 Livestock pens
11 Fuel storage
12 Fertilizer storage
13 Insecticide storage
14 Abandoned water well
15 Oil well/Gas well
16 Other (specify below) **contaminated site**

Direction from well? _____ How many feet? _____

FROM	TO	PLUGGING MATERIALS
17.2	3	Bentonite
3	0	Soil/ASphalt

7	CONTRACTOR'S OR LANDOWNER'S CERTIFICATION. This water well was plugged under my jurisdiction and was completed on (mo/day/year) 07/29/08 and this record is true to the best of my knowledge and belief. Kansas Water Well Contractor's License No 585 This Water Well Record was completed on (mo/day/year) 08/29/08 under the business name of Associated Environmental, Inc. By (signature) <i>Bradley Jones</i>
---	--

INSTRUCTIONS: Use typewriter or ball point pen. Please press firmly and print clearly. Please fill in blanks, underline or circle the correct answers. Send top three copies to Kansas Department of Health and Environment, Bureau of Water, Geology Section, 1000 SW Jackson St., Ste. 420, Topeka, Kansas 66612-1367. Telephone: 785/296-5522. Send one to Water Well Owner and retain one for your records.