


Well #2 Closest To House

**WATER WELL RECORD**

**Form WWC-5**

Division of Water Resources App. No.  

<b>1 LOCATION OF WATER WELL:</b> County: <u>Jefferson</u>	Fraction <u>EW 1/4 SW 1/4 SW 1/4</u> 1/4	Section Number <u>3</u>	Township No. T <u>11 N</u>	Range Number R <u>17 E</u> <input checked="" type="checkbox"/> <input type="checkbox"/> W
Street/Rural Address of Well Location; if unknown, distance & direction from nearest town or intersection: If at owner's address, check here <input checked="" type="checkbox"/> .		<b>Global Positioning System (GPS) information:</b> Latitude: ..... (in decimal degrees) Longitude: ..... (in decimal degrees) Elevation: ..... Datum: <input type="checkbox"/> WGS 84, <input type="checkbox"/> NAD 83, <input type="checkbox"/> NAD 27 Collection Method: <input type="checkbox"/> GPS unit (Make/Model: .....) <input type="checkbox"/> Digital Map/Photo, <input type="checkbox"/> Topographic Map, <input type="checkbox"/> Land Survey Est. Accuracy: <input type="checkbox"/> <3 m, <input type="checkbox"/> 3-5 m, <input type="checkbox"/> 5-15 m, <input type="checkbox"/> >15 m		
<b>2 WATER WELL OWNER:</b> <u>Bill Hilbert</u> RR#, Street Address, Box #: <u>3954 Denton Rd.</u> City, State, ZIP Code: <u>Meriden, KS 66512</u>				

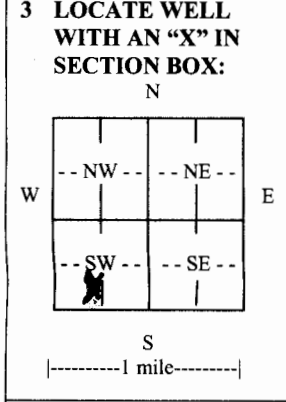

**4 DEPTH OF COMPLETED WELL** ..... 60 ft.

Depth(s) Groundwater Encountered (1)..... ft. (2)..... ft. (3)..... ft.

WELL'S STATIC WATER LEVEL..... 18.2 ft. below land surface measured on mo/day/yr.....

Pump test data: Well water was..... ft. after..... hours pumping..... gpm

EST. YIELD..... 34 gpm. Well water was..... ft. after..... hours pumping..... gpm

Bore Hole Diameter ..... 9" in. to ..... 60' ft., and ..... in. to ..... ft.

WELL WATER TO BE USED AS:  Public water supply  Geothermal  Injection well  
 Domestic  Feedlot  Oil field water supply  Dewatering  Other (Specify below)  
 Irrigation  Industrial  Domestic-lawn & garden  Monitoring well

Was a chemical/bacteriological sample submitted to Department?  Yes  No

If yes, mo/day/yr sample was submitted.....

Water well disinfected?  Yes  No

**5 TYPE OF CASING USED:**  Steel  PVC  Other .....

CASING JOINTS:  Glued  Clamped  Welded  Threaded

Casing diameter ..... 5 1/2" in. to ..... 49 ft., Diameter ..... in. to ..... ft., Diameter ..... in. to ..... ft.

Casing height above land surface..... 2' in., Weight 54.40 lbs./ft., Wall thickness or gauge No. ....

TYPE OF SCREEN OR PERFORATION MATERIAL:  
 Steel  Stainless Steel  PVC  Other (Specify) .....  
 Brass  Galvanized Steel  None used (open hole)

SCREEN OR PERFORATION OPENINGS ARE:  
 Continuous slot  Mill slot  Gauze wrapped  Torch cut  Drilled holes  None (open hole)  
 Louvered shutter  Key punched  Wire wrapped  Saw cut  Other (specify) .....

SCREEN-PERFORATED INTERVALS: From..... 4.0 ft. to ..... 60 ft., From ..... ft. to ..... ft.  
From..... ft. to ..... ft., From ..... ft. to ..... ft.

GRAVEL PACK INTERVALS: From..... 2.0 ft. to ..... 60 ft., From ..... ft. to ..... ft.  
From..... ft. to ..... ft., From ..... ft. to ..... ft.

**6 GROUT MATERIAL:**  Neat cement  Cement grout  Bentonite  Other .....

Grout Intervals: From ..... 0 ft. to ..... 20 ft., From ..... ft. to ..... ft., From ..... ft. to ..... ft.

What is the nearest source of possible contamination: None Close

<input type="checkbox"/> Septic tank	<input type="checkbox"/> Lateral lines	<input type="checkbox"/> Pit privy	<input type="checkbox"/> Livestock pens	<input type="checkbox"/> Insecticide storage	<input type="checkbox"/> Other (specify below)
<input type="checkbox"/> Sewer lines	<input type="checkbox"/> Cesspool	<input type="checkbox"/> Sewage lagoon	<input type="checkbox"/> Fuel storage	<input type="checkbox"/> Abandoned water well	
<input type="checkbox"/> Watertight sewer lines	<input type="checkbox"/> Seepage pit	<input type="checkbox"/> Feedyard	<input type="checkbox"/> Fertilizer storage	<input type="checkbox"/> Oil well/gas well	

Direction from well ..... Distance from well .....

FROM	TO	LITHOLOGIC LOG	FROM	TO	LITHO. LOG (cont.) or PLUGGING INTERVALS
0	1	Top Soil			
1	20	Brown Clay			
21	22	Brown Clay & Gravel (water)			
22	24	Limestone			
24	28	Brown Shale			
28	36	Limestone			
36	42	Grey Silty Shale			
42	44	Limestone			
44	60	Grey Shale			

**7 CONTRACTOR'S OR LANDOWNER'S CERTIFICATION:** This water well was  constructed,  reconstructed, or  plugged under my jurisdiction and was completed on (mo/day/year) 1/21/2013 and this record is true to the best of my knowledge and belief.

Kansas Water Well Contractor's License No. 451 This Water Well Record was completed on (mo/day/year) 1/17/2013  
under the business name of Waldman Well Drilling by (signature) Craig K. Waldman

**INSTRUCTIONS:** Use typewriter or ball point pen. PLEASE PRESS FIRMLY and PRINT clearly. Please fill in blanks and check the correct answers. Send three copies (white, blue, pink) to Kansas Department of Health and Environment, Bureau of Water, Geology Section, 1000 SW Jackson St., Suite 420, Topeka, Kansas 66612-1367. Telephone 785-296-5524. Send one copy to WATER WELL OWNER and retain one for your records. Include fee of \$5.00 for each constructed well. Visit us at <http://www.kdheks.gov/waterwell/index.html>.