


1 LOCATION OF WATER WELL: County: JEFFERSON Fraction NW 1/4 NW SW 1/4 Section Number 25 Township Number 11 Range Number 17 E/W 0

Distance and direction from nearest town or city street address of well if located within city?

1 MILE South 1 mile West 3/4 mile South of NEWMAN, KS

2 WATER WELL OWNER: ROBERT RUSSELL Global Positioning Systems (decimal degrees, min. of 4 digits)
 RR#, St. Address, Box #: 328 NORTH EATON DRIVE Latitude: _____
 City, State ZIP Code: LAWRENCE, KS 66049 Longitude: _____
 Elevation: _____
 Datum: _____
 Data Collection Method: _____

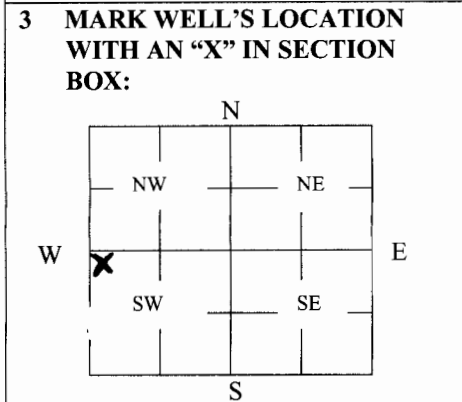

4 DEPTH OF WELL 51 ft.
 WELL'S STATIC WATER LEVEL 15' ft.
 WELL WAS USED AS:
 1 Domestic 5 Public Water Supply 9 Dewatering
 2 Irrigation 6 Oil Field Water Supply 10 Monitoring
 3 Feedlot 7 Domestic (Lawn & Garden) 11 Injection Well
 4 Industrial 8 Air Conditioning 12 Other _____
 Was a chemical/bacteriological sample submitted to Department? Yes _____ No _____

5 TYPE OF BLANK CASING USED:
 Steel 3 RMP (SR) 5 Wrought 7 Fiberglass 9 Other (Specify below) _____
 PVC 4 ABS 6 Asbestos-Cement 8 Concrete Tile _____
 Blank casing diameter 16 in. Was casing pulled? Yes _____ No If yes, how much _____
 Casing height ~~above~~ or below land surface 6 FT

6 GROUT PLUG MATERIAL: 1 Neat cement 2 Cement grout 3 Bentonite 4 Other _____
 Grout Plug Intervals: From 51 ft. to 6 ft., From _____ ft. to _____ ft., From _____ to _____ ft.
 What is the nearest source of possible contamination:
 1 Septic tank 6 Seepage pit 11 Fuel Storage 16 Other (specify below) KANSAS RIVER
 2 Sewer lines 7 Pit privy 12 Fertilizer storage
 3 Watertight sewer lines 8 Sewage lagoon 13 Insecticide storage
 4 Lateral lines 9 Feedyard 14 Abandoned water well Direction from well? South
 5 Cess pool 10 Livestock pens 15 Oil well/Gas well How many feet? 600'

FROM	TO	PLUGGING MATERIALS	FROM	TO	PLUGGING MATERIALS
<u>51</u>	<u>6</u>	<u>Bentonite Hull plug</u>			
<u>6</u>	<u>0</u>	<u>Top Soil</u>			

7 CONTRACTOR'S OR LANDOWNER'S CERTIFICATION: This water well was plugged under my jurisdiction and was completed on (mo/day/year) 12/2/14 and this record is true to the best of my knowledge and belief. Kansas Water Well Contractor's License No. 536. This Water Well Record was completed on (mo/day/year) 12/5/14 under the business name of Atchew Pump & Well Drilling, Inc. by (signature) Lora E. Atchew

INSTRUCTIONS: Use typewriter or ballpoint pen. Please press firmly and print clearly. Please fill in blanks, underline or circle the correct answers. Send top three copies to Kansas Department of Health and Environment, Bureau of Water, Geology Section, 1000 SW Jackson St., Ste. 420, Topeka, Kansas 66612-1367. Telephone: 785/296-5522. Send one to Water Well Owner and retain one for your records. Visit us at <http://www.kdheks.gov/geo/waterwells>.