

WATER WELL RECORD Form WWC-5

Correction


Division of Water Resources App. No.

Well ID

Original Record Correction Change in Well Use

1 LOCATION OF WATER WELL: County: Jefferson Fraction NE 1/4 SE 1/4 SE 1/4 NE 1/4 Section Number 14 Township Number T 11 S Range Number R 17 E W

2 WELL OWNER: Last Name: Hare First: Steve Street or Rural Address where well is located: 2801 Ellsworth rd Perry KS

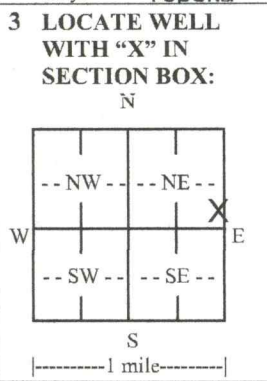

4 DEPTH OF COMPLETED WELL: 100 ft. Depth(s) Groundwater Encountered: 1) 61 ft. 2) ... 3) ... 4) Dry Well

5 Latitude: 39.096076 Longitude: -95.483816 Datum: WGS 84

6 Elevation: ... Ground Level TOC Source: Land Survey GPS Topographic Map Other

7 WELL WATER TO BE USED AS: 1. Domestic Household 2. Irrigation 3. Feedlot 4. Industrial 5. Public Water Supply 6. Dewatering 7. Aquifer Recharge 8. Monitoring 9. Environmental Remediation 10. Oil Field Water Supply 11. Test Hole 12. Geothermal 13. Other

Was a chemical/bacteriological sample submitted to KDHE? Yes No If yes, date sample was submitted: Water well disinfected? Yes No

8 TYPE OF CASING USED: Steel PVC Other CASING JOINTS: Glued Clamped Welded Threaded Casing diameter 6 in. to 100 ft. Diameter in. to ... Casing height above land surface 24 in. Weight lbs./ft. Wall thickness or gauge No. SDR26

TYPE OF SCREEN OR PERFORATION MATERIAL: Steel Stainless Steel PVC Galvanized Steel Other (Specify) None used (open hole)

SCREEN OR PERFORATION OPENINGS ARE: Continuous Slot Mill Slot Gauze Wrapped Torch Cut Drilled Holes Other (Specify) Louvered Shutter Key Punched Wire Wrapped Saw Cut None (Open Hole)

SCREEN-PERFORATED INTERVALS: From 40 ft. to 80 ft. GRAVEL PACK INTERVALS: From 23 ft. to 100 ft.

9 GROUT MATERIAL: Neat cement Cement grout Bentonite Other Grout Intervals: From 0 ft. to 23 ft.

Nearest source of possible contamination: No potential source of contamination within 200 ft. Septic Tank Lateral Lines Pit Privy Livestock Pens Insecticide Storage Sewer Lines Cess Pool Sewage Lagoon Fuel Storage Abandoned Water Well Watertight Sewer Lines Seepage Pit Feedyard Fertilizer Storage Oil Well/Gas Well Other (Specify) House Direction from well? West Distance from well? 60 ft.

Table with columns: FROM, TO, LITHOLOGIC LOG, FROM, TO, LITHO. LOG (cont.) or PLUGGING INTERVALS. Rows: 0-18 Clay, tan sandy; 18-38 Clay, tan silty; 38-44 Sand, fine; 44-61 Clay, Gray; 61-64 Sand, fine/med; 64-68 Clay, gray; 68-80 Limestone; 80-86 Shale, gray; 86-100 Limestone.

11 CONTRACTOR'S OR LANDOWNER'S CERTIFICATION: This water well was constructed, reconstructed, or plugged under my jurisdiction and was completed on (mo-day-year) 07/23/2021 and this record is true to the best of my knowledge and belief. Kansas Water Well Contractor's License No. 760 This Water Well Record was completed on (mo-day-year) 07/23/2021 under the business name of Associated Drilling, Inc.