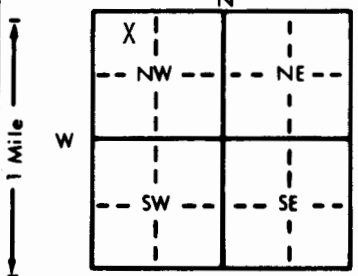


1 LOCATION OF WATER WELL: Fraction NE 1/4 NW 1/4 NW 1/4 Section Number 32 Township Number T 11 S Range Number R 17 E
 County: Shawnee
 Distance and direction from nearest town or city street address of well if located within city? _____


2 WATER WELL OWNER: Flexel, Inc.
 RR#, St. Address, Box # : 6000 SE 2nd St. Board of Agriculture, Division of Water Resources
 City, State, ZIP Code : Tecumseh, Ks. 66542 Application Number: _____

3 LOCATE WELL'S LOCATION WITH AN "X" IN SECTION BOX:

 4 DEPTH OF COMPLETED WELL 43.2 ft. ELEVATION: _____
 Depth(s) Groundwater Encountered 1. 40 ft. 2. _____ ft. 3. _____ ft.
 WELL'S STATIC WATER LEVEL 4.0 ft. below land surface measured on mo/day/yr _____
 Pump test data: Well water was _____ ft. after _____ hours pumping _____ gpm
 Est. Yield _____ gpm: Well water was _____ ft. after _____ hours pumping _____ gpm
 Bore Hole Diameter 9.5 in. to 18 in., and 5.5/8 in. to 43.2 ft.
 WELL WATER TO BE USED AS: 5 Public water supply 8 Air conditioning 11 Injection well
 1 Domestic 3 Feedlot 6 Oil field water supply 9 Dewatering 12 Other (Specify below)
 2 Irrigation 4 Industrial 7 Lawn and garden only Observation well
 Was a chemical/bacteriological sample submitted to Department? Yes _____ No X _____; If yes, mo/day/yr sample was sub-
 mitted _____ Water Well Disinfected? Yes _____ No X _____

5 TYPE OF BLANK CASING USED:
 1 Steel 3 RMP (SR) 5 Wrought iron 8 Concrete tile CASING JOINTS: Glued _____ Clamped _____
 2 PVC 4 ABS 6 Asbestos-Cement 9 Other (specify below) Welded _____
 7 Fiberglass _____ Threaded X _____
 Blank casing diameter 6 in. to 18 in., Dia 2 in. to 33.2 in., Dia _____ in. to _____ ft.
 Casing height above land surface 30 in., weight _____ lbs./ft. Wall thickness or gauge No. _____
 TYPE OF SCREEN OR PERFORATION MATERIAL:
 1 Steel 3 Stainless steel 5 Fiberglass 8 RMP (SR) 10 Asbestos-cement
 2 Brass 4 Galvanized steel 6 Concrete tile 9 ABS 11 Other (specify) _____
 12 None used (open hole)
 SCREEN OR PERFORATION OPENINGS ARE:
 1 Continuous slot 3 Mill slot 6 Wire wrapped 8 Saw cut 11 None (open hole)
 2 Louvered shutter 4 Key punched 7 Torch cut 9 Drilled holes
 10 Other (specify) _____
 SCREEN-PERFORATED INTERVALS: From 33.2 ft. to 43.2 ft., From _____ ft. to _____ ft.
 From _____ ft. to _____ ft., From _____ ft. to _____ ft.
 GRAVEL PACK INTERVALS: From 31.2 ft. to 43.2 ft., From _____ ft. to _____ ft.
 From _____ ft. to _____ ft., From _____ ft. to _____ ft.

6 GROUT MATERIAL: 1 Neat cement 2 Cement grout 3 Bentonite 4 Other _____
 Grout Intervals: From 29.2 ft. to 31.2 ft., From 0.0 ft. to 29.2 ft., From _____ ft. to _____ ft.
 What is the nearest source of possible contamination:
 1 Septic tank 4 Lateral lines 7 Pit privy 10 Livestock pens 14 Abandoned water well
 2 Sewer lines 5 Cess pool 8 Sewage lagoon 11 Fuel storage 15 Oil well/Gas well
 3 Watertight sewer lines 6 Seepage pit 9 Feedyard 12 Fertilizer storage 16 Other (specify below)
 13 Insecticide storage Landfill _____
 Direction from well? _____ How many feet? _____

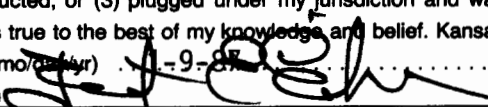FROM	TO	LITHOLOGIC LOG	FROM	TO	LITHOLOGIC LOG
0.0	2.0	Dark Gray Brown Silty Topsoil			
2.0	16.7	Dark Gray Brown Lean Clay			
16.7	19.8	Gray Calcareous Shale			
19.8	24.3	Light Brown Limestone			
24.3	26.4	Gray Shale			
26.4	28.5	Black Shale			
28.5	30.5	Light Brown Limestone			
30.5	33.5	Gray Shale With Limestone Stringers			
33.5	38.4	Limestone With Shale Stringers			
38.4	43.2	Light Gray Limestone			
43.2		Gray Shale			

7 CONTRACTOR'S OR LANDOWNER'S CERTIFICATION: This water well was 1 constructed, (2) reconstructed, or (3) plugged under my jurisdiction and was completed on (mo/day/year) 12-31-86 and this record is true to the best of my knowledge and belief. Kansas Water Well Contractor's License No. 4.16 This Water Well Record was completed on (mo/day/year) 9-87 under the business name of Terracon Consultants Inc. by (signature) 

INSTRUCTIONS: Use typewriter or ball point pen. PLEASE PRESS FIRMLY and PRINT clearly. Please fill in blanks, underline or circle the correct answers. Send top three copies to Kansas Department of Health and Environment, Office of Oil Field and Environmental Geology, Regulation and Permitting Section, Topeka, Kansas 66620-7500, Telephone: 913-862-9360. Send one to WATER WELL OWNER and retain one for your records.