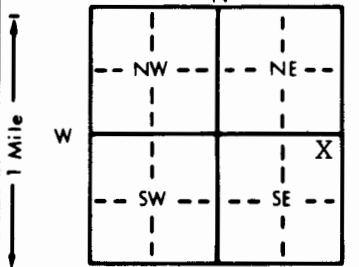


1 LOCATION OF WATER WELL: County: JEFFERSON		Fraction NE 1/4 NE 1/4 SE 1/4	Section Number 23	Township Number T 11 S	Range Number R 18E E/W	
Distance and direction from nearest town or city street address of well if located within city? 3/4 mile east of Perry 1st place E. of Randy's house	
2 WATER WELL OWNER: Randy Harries RR#, St. Address, Box #: Rt. 1 Box 505 H (2) Heat Pump Holes Board of Agriculture, Division of Water Resources City, State, ZIP Code: Perry, KS 66073 Application Number:	
3 LOCATE WELL'S LOCATION WITH AN "X" IN SECTION BOX: 		4 DEPTH OF COMPLETED WELL: 125' ft. ELEVATION: Depth(s) Groundwater Encountered 1. ft. 2. ft. 3. ft. WELL'S STATIC WATER LEVEL ft. below land surface measured on mo/day/yr Pump test data: Well water was ft. after hours pumping gpm Est. Yield gpm: Well water was ft. after hours pumping gpm Bore Hole Diameter in. to ft. and in. to ft. WELL WATER TO BE USED AS: 5 Public water supply 8 Air conditioning 11 Injection well 1 Domestic 3 Feedlot 6 Oil field water supply 9 Dewatering 12 Other (Specify below) 2 Irrigation 4 Industrial 7 Lawn and garden only 10 Monitoring well heat pump Was a chemical/bacteriological sample submitted to Department? Yes No; If yes, mo/day/yr sample was submitted Water Well Disinfected? Yes No	
5 TYPE OF BLANK CASING USED: 1 Steel 3 RMP (SR) 5 Wrought iron 8 Concrete tile CASING JOINTS: Glued Clamped 2 PVC 4 ABS 6 Asbestos-Cement 9 Other (specify below) Welded Blank casing diameter in. to ft. Dia in. to ft. Dia in. to ft. Casing height above land surface in. weight lbs./ft. Wall thickness or gauge No. TYPE OF SCREEN OR PERFORATION MATERIAL: 1 Steel 3 Stainless steel 5 Fiberglass 8 RMP (SR) 10 Asbestos-cement 2 Brass 4 Galvanized steel 6 Concrete tile 9 ABS 11 Other (specify) SCREEN OR PERFORATION OPENINGS ARE: 1 Continuous slot 3 Mill slot 5 Gauzed wrapped 8 Saw cut 11 None (open hole) 2 Louvered shutter 4 Key punched 7 Torch cut 9 Drilled holes SCREEN-PERFORATED INTERVALS: From ft. to ft. From ft. to ft. GRAVEL PACK INTERVALS: From ft. to ft. From ft. to ft.	
6 GROUT MATERIAL: 1 Neat cement 2 Cement grout 3 Bentonite 4 Other Grout Intervals: From 0 ft. to 125 ft. From ft. to ft. From ft. to ft. What is the nearest source of possible contamination: 1 Septic tank 4 Lateral lines 7 Pit privy 10 Livestock pens 14 Abandoned water well 2 Sewer lines 5 Cess pool 8 Sewage lagoon 11 Fuel storage 15 Oil well/Gas well 3 Watertight sewer lines 6 Seepage pit 9 Feedyard 12 Fertilizer storage 16 Other (specify below) 13 Insecticide storage Direction from well? south How many feet? 140'	
<table border="1"><thead><tr><th>FROM</th><th>TO</th><th>LITHOLOGIC LOG</th><th>FROM</th><th>TO</th><th>PLUGGING INTERVALS</th></tr></thead><tbody><tr><td>0</td><td>10</td><td>Yellow shale</td><td>81</td><td>82</td><td>Grey Limestone</td></tr><tr><td>10</td><td>11</td><td>Yellow Limestone</td><td>82</td><td>118</td><td>Grey Shale</td></tr><tr><td>11</td><td>15</td><td>Yellow shale</td><td>118</td><td>125</td><td>Grey Limestone</td></tr><tr><td>15</td><td>17</td><td>Yellow Limestone</td><td></td><td></td><td></td></tr><tr><td>17</td><td>22</td><td>Yellow Shale</td><td></td><td></td><td></td></tr><tr><td>22</td><td>28</td><td>Grey Shale</td><td></td><td></td><td></td></tr><tr><td>28</td><td>29</td><td>Black Shale</td><td></td><td></td><td></td></tr><tr><td>29</td><td>33</td><td>Grey Limestone</td><td></td><td></td><td></td></tr><tr><td>33</td><td>35</td><td>Grey Shale</td><td></td><td></td><td></td></tr><tr><td>35</td><td>46</td><td>Grey Limestone</td><td></td><td></td><td></td></tr><tr><td>46</td><td>51</td><td>Grey Shale</td><td></td><td></td><td></td></tr><tr><td>51</td><td>57</td><td>Grey Sandstone</td><td></td><td></td><td></td></tr><tr><td>57</td><td>74</td><td>Grey Shale</td><td></td><td></td><td></td></tr><tr><td>74</td><td>77</td><td>Grey Limestone</td><td></td><td></td><td></td></tr><tr><td>77</td><td>81</td><td>Grey Shale</td><td></td><td></td><td></td></tr>
7 CONTRACTOR'S OR LANDOWNER'S CERTIFICATION: This water well was (1) constructed, (2) reconstructed, or (3) plugged under my jurisdiction and was completed on (mo/day/year) 1-16-96 and this record is true to the best of my knowledge and belief. Kansas Water Well Contractor's License No. 182 This Water Well Record was completed on (mo/day/yr) 2-20-96 under the business name of STRADER DRILLING CO., INC. by (signature) Dale Skoren	
INSTRUCTIONS: Use typewriter or ball point pen. PLEASE PRESS FIRMLY and PRINT clearly. Please fill in blanks, underline or circle the correct answers. Send top three copies to Kansas Department of Health and Environment, Bureau of Water, Topeka, Kansas 66620-0001. Telephone: 913-296-5545. Send one to WATER WELL OWNER and retain one for your records.	