


1 LOCATION OF WATER WELL: County: Jefferson	Fraction NE 1/4 NE 1/4 NE 1/4	Section Number 25	Township Number T 11 S	Range Number R 18
--	----------------------------------	----------------------	---------------------------	----------------------

Distance and direction from nearest town or city street address of well if located within city?
Approximately 2 miles east of Perry

2 WATER WELL OWNER: Jefferson County RWD #2
 RR#, St. Address, Box # : P.O. Box 140
 City, State, ZIP Code : Perry, KS 66075
 Board of Agriculture, Division of Water Resources
 Application Number:

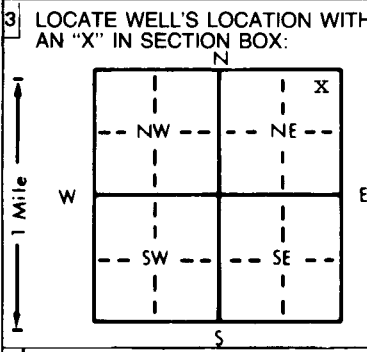

4 DEPTH OF COMPLETED WELL: 76 ft. ELEVATION: unknown
 Depth(s) Groundwater Encountered 1. ft. 2. ft. 3. ft.
 WELL'S STATIC WATER LEVEL . . . 15.2 . . . ft. below land surface measured on mo/day/yr . . . 4-3-97
 Pump test data: Well water was not ch'd. ft. after hours pumping gpm
 Est. Yield unknown gpm: Well water was ft. after hours pumping gpm
 Bore Hole Diameter . . . 8 . . . in. to . . . 80 . . . ft., and in. to ft.
 WELL WATER TO BE USED AS:
 1 Domestic 3 Feedlot 6 Oil field water supply 9 Dewatering 12 Other (Specify below)
 2 Irrigation 4 Industrial 7 Lawn and garden only 10 Monitoring well Test Well
 Was a chemical/bacteriological sample submitted to Department? Yes. No. ; If yes, mo/day/yr sample was submitted
 Water Well Disinfected? Yes No

5 TYPE OF CASING USED:
 1 Steel 3 RMP (SR) 5 Wrought iron 8 Concrete tile CASING JOINTS: Glued Clamped
 2 PVC 4 ABS 6 Asbestos-Cement 9 Other (specify below) Welded
 7 Fiberglass Threaded
 Blank casing diameter . . . 5 . . . in. to . . . 54 . . . ft., Dia . . . in. to ft., Dia . . . in. to ft.
 Casing height above land surface . . . 24 . . . in., weight . . . 2.36 . . . lbs./ft. Wall thickness or gauge No. . . . 214
 TYPE OF SCREEN OR PERFORATION MATERIAL:
 1 Steel 3 Stainless steel 5 Fiberglass 7 PVC 10 Asbestos-cement
 2 Brass 4 Galvanized steel 6 Concrete tile 8 RMP (SR) 11 Other (specify)
 9 ABS 12 None used (open hole)
 SCREEN OR PERFORATION OPENINGS ARE:
 1 Continuous slot 3 Mill slot 5 Gauzed wrapped 8 Saw cut 11 None (open hole)
 2 Louvered shutter 4 Key punched 6 Wire wrapped 9 Drilled holes
 7 Torch cut 10 Other (specify)
 SCREEN-PERFORATED INTERVALS: From . . . 54 . . . ft. to . . . 74 . . . ft., From ft. to ft.
 From ft. to ft., From ft. to ft.
 GRAVEL PACK INTERVALS: From . . . 20 . . . ft. to . . . 33 . . . ft., From ft. to ft.
 From . . . 44 . . . ft. to . . . 80 . . . ft., From ft. to ft.

6 GROUT MATERIAL: 1 Neat cement 2 Cement grout 3 Bentonite 4 Other . . . Bentonite Holeplug
 Grout Intervals: From ft. to ft., From . . . 0 . . . ft. to . . . 20 . . . ft., From . . . 33 . . . ft. to . . . 44 . . . ft.
 What is the nearest source of possible contamination:
 1 Septic tank 4 Lateral lines 7 Pit privy 10 Livestock pens 14 Abandoned water well
 2 Sewer lines 5 Cess pool 8 Sewage lagoon 11 Fuel storage 15 Oil well/Gas well
 3 Watertight sewer lines 6 Seepage pit 9 Feedyard 12 Fertilizer storage 16 Other (specify below)
 13 Insecticide storage . . . None known

Direction from well? How many feet?

FROM	TO	LITHOLOGIC LOG	FROM	TO	PLUGGING INTERVALS
0	3	Topsoil			
3	7	Clay, black, hard			
7	19	Clay, brownish-tan, soft			
19	74	Sand and gravel, coarse, medium, fine			
74	80	Shale, bluish-gray, hard			

7 CONTRACTOR'S OR LANDOWNER'S CERTIFICATION: This water well was (1) constructed, (2) reconstructed, or (3) plugged under my jurisdiction and was completed on (mo/day/year) 4-3-97 and this record is true to the best of my knowledge and belief. Kansas Water Well Contractor's License No. 185 This Water Well Record was completed on (mo/day/yr) 4-9-97 under the business name of Clarke Well & Equipment, Inc. by (signature) *Clarke Well & Equipment*

OFFICE USE ONLY
T
R
EW
SEC.
1/4
1/4
1/4