


1 LOCATION OF WATER WELL: County: JEFFERSON Fraction: SE 1/4 NW 1/4 SW 1/4 Section Number: 26 Township Number: T 11 S Range Number: R 18 EW

Distance and direction from nearest town or city street address of well if located within city? FROM PERRY KS., ONE & ONE-HALF MILE SOUTH, 1/2 MILE WEST

2 WATER WELL OWNER: DON & MARY K. HURD RR#, St. Address, Box #: R. R. 1 BOX 494 City, State, ZIP Code: PERRY KS. 66073 Board of Agriculture, Division of Water Resources Application Number: 41447

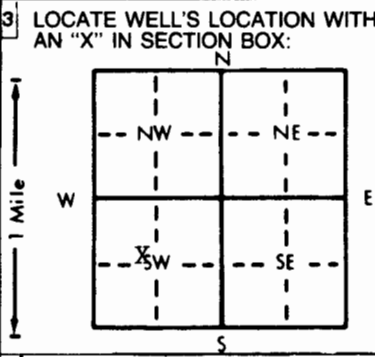

3 LOCATE WELL'S LOCATION WITH AN 'X' IN SECTION BOX: 4 DEPTH OF COMPLETED WELL: 58 ft. ELEVATION: ... WELL'S STATIC WATER LEVEL: 19 ft. below land surface ... Pump test data: Well water was 27 ft. after 1 hour pumping 800 gpm ...

5 TYPE OF BLANK CASING USED: 1 Steel, 2 PVC, 3 RMP (SR), 4 ABS, 5 Wrought iron, 6 Asbestos-Cement, 7 Fiberglass, 8 Concrete tile, 9 Other (specify below), 10 Asbestos-cement, 11 Other (specify) ... SCREEN OR PERFORATION MATERIAL: 1 Steel, 2 Brass, 3 Stainless steel, 4 Galvanized steel, 5 Fiberglass, 6 Concrete tile, 7 PVC, 8 RMP (SR), 9 ABS, 10 Asbestos-cement, 11 Other (specify), 12 None used (open hole) ...

6 GROUT MATERIAL: 1 Neat cement, 2 Cement grout, 3 Bentonite, 4 Other ... Grout intervals: From 0 ft. to 20 ft. ... What is the nearest source of possible contamination: 1 Septic tank, 2 Sewer lines, 3 Watertight sewer lines, 4 Lateral lines, 5 Cess pool, 6 Seepage pit, 7 Pit privy, 8 Sewage lagoon, 9 Feedyard, 10 Livestock pens, 11 Fuel storage, 12 Fertilizer storage, 13 Insecticide storage, 14 Abandoned water well, 15 Oil well/Gas well, 16 Other (specify below), 17 NONE ...

Direction from well? How many feet? Table with columns: FROM, TO, LITHOLOGIC LOG, FROM, TO, PLUGGING INTERVALS. Rows include: 0-2 BLACK TOP SOIL, 2-17 BROWN SILT, 17-24 SMALL-MEDIUM BROWN GRAVEL & GREY CLAY, 24-29 SMALL GREY GRAVEL, 29-32 MEDIUM GREY GRAVEL & GREY CLAY, 32-35 MEDIUM-LARGE GREY GRAVEL, 35-38 MEDIUM GREY GRAVEL & GREY CLAY, 38-44 MEDIUM-LARGE GREY GRAVEL, 44-51 SMALL GREY SAND, 51-58 MEDIUM-LARGE GREY GRAVEL, 58 SHALE, STOPPED

7 CONTRACTOR'S OR LANDOWNER'S CERTIFICATION: This water well was (1) constructed, (2) reconstructed, or (3) plugged under my jurisdiction and was completed on (mo/day/year) 5-15-97 and this record is true to the best of my knowledge and belief. Kansas Water Well Contractor's License No. 323 This Water Well Record was completed on (mo/day/yr) 5-21-97 under the business name of HOUBLER DRILLING CO. by (signature)

OFFICE USE ONLY T R EW SEC. 1/4