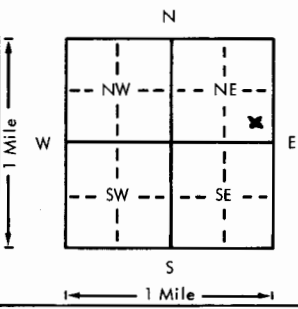
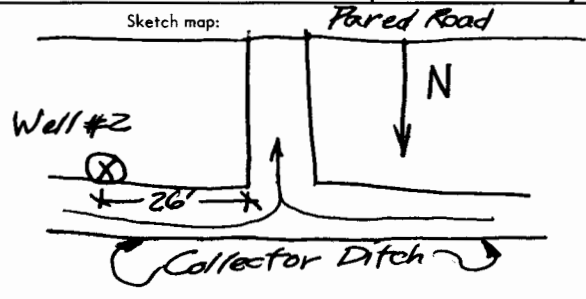


USE TYPEWRITER OR BALL POINT PEN-PRESS FIRMLY, PRINT CLEARLY.

WATER WELL RECORD
KSA 82a-1201-1215

add

Kansas Department of Health and Environment-Division of Environment
(Water well Contractors)
Topeka, Kansas 66620

1. Location of well: County <u>Jefferson</u> Fraction <u>SE 1/4 SE 1/4 NE 1/4</u> Section number <u>8</u> Township number <u>T 11 S R 18</u> Range number <u>18</u> <input checked="" type="checkbox"/> EAW	
2. Distance and direction from nearest town or city: <u>4 Mi N.W Perry Ks.</u> 3. Owner of well: <u>U.S. Govt. Corps of Engineers</u> Street address of well location if in city: <u>Perry Project Office</u> City, state, zip code: <u>Perry, Ks.</u>	
4. Locate with "X" in section below:  Sketch map: 	
6. Bore hole dia. <u>18"</u> in. Completion date <u>4-27-78</u> Well depth <u>67'6"</u> ft.	
7. <input checked="" type="checkbox"/> Cable tool <input checked="" type="checkbox"/> Rotary <input type="checkbox"/> Driven <input type="checkbox"/> Dug <input type="checkbox"/> Hollow rod <input type="checkbox"/> Jetted <input type="checkbox"/> Bored <input type="checkbox"/> Reverse rotary	
8. Use: <input type="checkbox"/> Domestic <input type="checkbox"/> Public supply <input type="checkbox"/> Industry <input type="checkbox"/> Irrigation <input type="checkbox"/> Air conditioning <input type="checkbox"/> Stock <input type="checkbox"/> Lawn <input type="checkbox"/> Oil field water <input checked="" type="checkbox"/> Other	
9. Casing: Material <u>Steel</u> Height: Above or below Threaded <input type="checkbox"/> Welded <input checked="" type="checkbox"/> Surface <u>30"</u> in. RMP <input type="checkbox"/> PVC <input type="checkbox"/> Weight <u>28.6</u> lbs./ft. Dia. <u>8</u> in. to <u>36</u> ft. depth Wall Thickness: inches or Dia. <input type="checkbox"/> in. to <input type="checkbox"/> ft. depth gage No. <u>0.322"</u>	
5. Type and color of material	
10. Screen: Manufacturer's name <u>Johnson</u> Type <u>Wire-Wound</u> Dia. <u>8"</u> Slot/gauze <u>40</u> Length <u>31'0"</u> Set between <u>36'6"</u> ft. and <u>67'6"</u> ft. ft. and <input type="checkbox"/> ft. Gravel pack? <input checked="" type="checkbox"/> YES Size range of material <u>0.10"</u>	
11. Static water level: <u>1.8</u> ft. below land surface Date <u>5-1-78</u> mo./day/yr.	
12. Pumping level below land surfaces: <u>6</u> ft. after <u>1</u> hrs. pumping <u>200</u> g.p.m. <input type="checkbox"/> ft. after <input type="checkbox"/> hrs. pumping <input type="checkbox"/> g.p.m. Estimated maximum yield <u>300</u> g.p.m.	
13. Water sample submitted: <input checked="" type="checkbox"/> Yes <input type="checkbox"/> No Date <input type="checkbox"/> mo./day/yr.	
14. Well head completion: <input type="checkbox"/> Pitless adapter <u>24</u> Inches above grade	
15. Well grouted? <input checked="" type="checkbox"/> YES With: <input checked="" type="checkbox"/> Neat cement <input type="checkbox"/> Bentonite <input type="checkbox"/> Concrete Depth: From <u>0</u> ft. to <u>11</u> ft.	
16. Nearest source of possible contamination: ft. <u>265</u> Direction <u>S</u> Type <u>Road</u> Well disinfected upon completion? <input checked="" type="checkbox"/> Yes <input type="checkbox"/> No	
17. Pump: <input checked="" type="checkbox"/> Not installed Manufacturer's name <input type="checkbox"/> HP <input type="checkbox"/> Volts <input type="checkbox"/> Model number <input type="checkbox"/> Length of drop pipe <input type="checkbox"/> ft. capacity <input type="checkbox"/> g.p.m. Type: <input type="checkbox"/> Submersible <input type="checkbox"/> Turbine <input type="checkbox"/> Jet <input type="checkbox"/> Reciprocating <input type="checkbox"/> Centrifugal <input type="checkbox"/> Other	
18. Elevation: <u>850'</u> Topography: <input checked="" type="checkbox"/> Hill <input type="checkbox"/> Slope <input type="checkbox"/> Upland <input checked="" type="checkbox"/> Valley	
19. Remarks: <u>Pressure relief well, Corps constructed underground discharge</u>	
20. Water well contractor's certification: This well was drilled under my jurisdiction and this report is true to the best of my knowledge and belief. <u>Layne Western Co. Inc. 199</u> Business name <u>1010 W 39 K.C. Mo</u> License No. <input type="checkbox"/> Address <u>1010 W 39 K.C. Mo</u> Signed <u>D. B. [Signature]</u> Date <u>11-2-78</u> Authorized representative	

BR elev = 784 1/2

11-1800-8 SESENE 1/4 1/4 1/4