


1 LOCATION OF WATER WELL: County: Jefferson Fraction: CN 1/4 NW 1/4 RW 1/4 Section Number: 16 Township Number: T 11 S Range Number: R 18 E

Distance and direction from nearest town or city street address of well if located within city?
2 1/2 miles west 1 mile North of Perry

2 WATER WELL OWNER: Pat Shaffer
 RR#, St. Address, Box #: Perry, Kansas.
 City, State, ZIP Code: Perry, Kansas.
 Board of Agriculture, Division of Water Resources
 Application Number:

3 LOCATE WELL'S LOCATION WITH AN "X" IN SECTION BOX: X in NW corner of section.
 4 DEPTH OF COMPLETED WELL: 74 ft. ELEVATION: 45' ft.
 Depth(s) Groundwater Encountered 1. 10' ft. 2. 45' ft. 3. _____ ft.
 WELL'S STATIC WATER LEVEL 6 ft. below land surface measured on Nov. 25, 1986

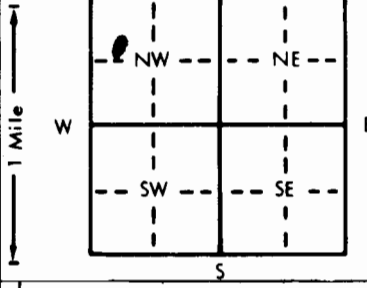

Pump test data: Well water was _____ ft. after _____ hours pumping _____ gpm
 Est. Yield 20* gpm: Well water was _____ ft. after _____ hours pumping _____ gpm
 Bore Hole Diameter 8" in. to 74' ft., and _____ in. to _____ ft.
 WELL WATER TO BE USED AS:
 Domestic 3 Feedlot 6 Oil field water supply 9 Dewatering 12 Other (Specify below)
 2 Irrigation 4 Industrial 7 Lawn and garden only 10 Observation well
 Was a chemical/bacteriological sample submitted to Department? Yes _____ No X; If yes, mo/day/yr sample was submitted _____
 Water Well Disinfected? Yes X No _____

5 TYPE OF BLANK CASING USED:
 1 Steel 3 RMP (SR) 5 Wrought iron 8 Concrete tile CASING JOINTS: Glued X Clamped _____
 2 PVC 4 ABS 7 Fiberglass _____ Welded _____
 Blank casing diameter 5" in. to 6.5 ft., Dia _____ in. to _____ ft., Dia _____ in. to _____ ft.
 Casing height above land surface 24" in., weight _____ lbs./ft. Wall thickness or gauge No. SDR 26

TYPE OF SCREEN OR PERFORATION MATERIAL:
 1 Steel 3 Stainless steel 5 Fiberglass 8 RMP (SR) 10 Asbestos-cement 11 Other (specify) _____
 2 Brass 4 Galvanized steel 6 Concrete tile 9 ABS 12 None used (open hole)
 SCREEN OR PERFORATION OPENINGS ARE:
 1 Continuous slot Mill slot 5 Gauzed wrapped 8 Saw cut 11 None (open hole)
 2 Louvered shutter 4 Key punched 6 Wire wrapped 9 Drilled holes
 7 Torch cut 10 Other (specify) _____

SCREEN-PERFORATED INTERVALS: From 65 ft. to 74 ft., From _____ ft. to _____ ft.
 GRAVEL PACK INTERVALS: From None ft. to _____ ft., From _____ ft. to _____ ft.

6 GROUT MATERIAL: Neat cement 2 Cement grout 3 Bentonite 4 Other _____
 Grout Intervals: From 0 ft. to 15' ft., From _____ ft. to _____ ft., From _____ ft. to _____ ft.
 What is the nearest source of possible contamination:
 1 Septic tank 4 Lateral lines 7 Pit privy 10 Livestock pens 14 Abandoned water well
 2 Sewer lines 5 Cess pool 8 Sewage lagoon 11 Fuel storage 15 Oil well/Gas well
 3 Watertight sewer lines 6 Seepage pit 9 Feedyard 12 Fertilizer storage 16 Other (specify below) Unknown
 13 Insecticide storage
 Direction from well? _____ How many feet? 100+

FROM	TO	LITHOLOGIC LOG	FROM	TO	LITHOLOGIC LOG
0	43	clay			
43	55	sand grey			
55	61	sand brown			
61	62	clay			
62	65	sand brown			
65	74	sand + gravel brown			

7 CONTRACTOR'S OR LANDOWNER'S CERTIFICATION: This water well was constructed, (2) reconstructed, or (3) plugged under my jurisdiction and was completed on (mo/day/year) Nov. 25, 1985 and this record is true to the best of my knowledge and belief. Kansas Water Well Contractor's License No. 316 This Water Well Record was completed on (mo/day/yr) Nov. 15, 1986 under the business name of Robison Drilling by (signature) Just Robison

INSTRUCTIONS: Use typewriter or ball point pen, PLEASE PRESS FIRMLY and PRINT clearly. Please fill in blanks underline or circle the correct answers. Send top three copies to Kansas Department of Health and Environment, Division of Environment, Environmental Geology Section, Topeka, KS 66620. Send one to WATER WELL OWNER and retain one for your records.

OFFICE USE ONLY